


T.3S. R.3W. W.M.

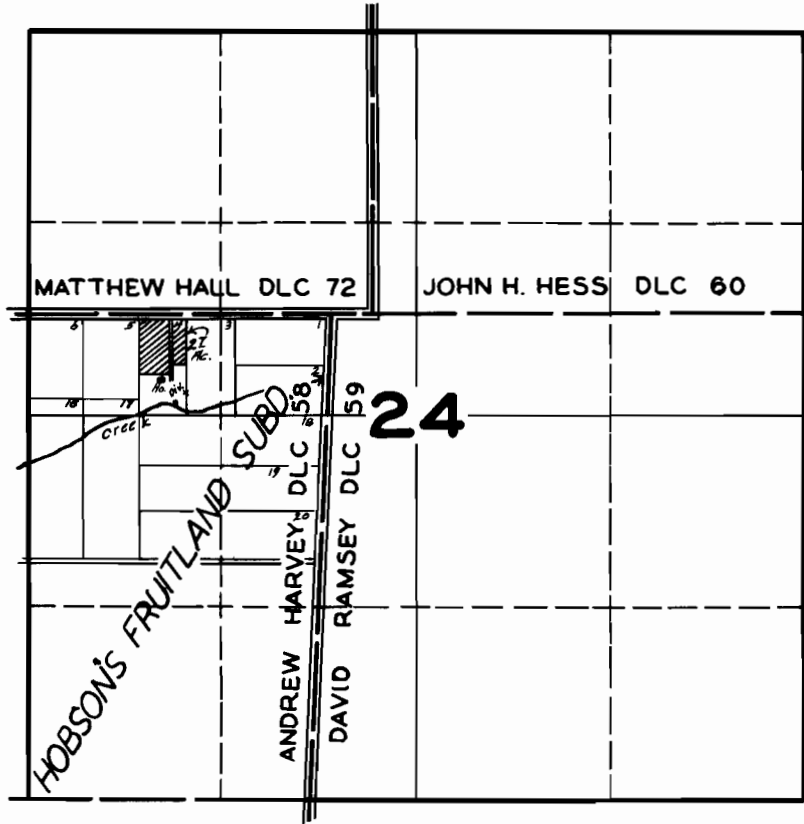

FINAL PROOF SURVEY

UNDER

Application No. 19493 Permit No. 15072

IN FAVOR OF

N. W. HAZLETON

Surveyed JAN. 27 1945, by *[Signature]*