


# T.8S. R.4W.W.M.

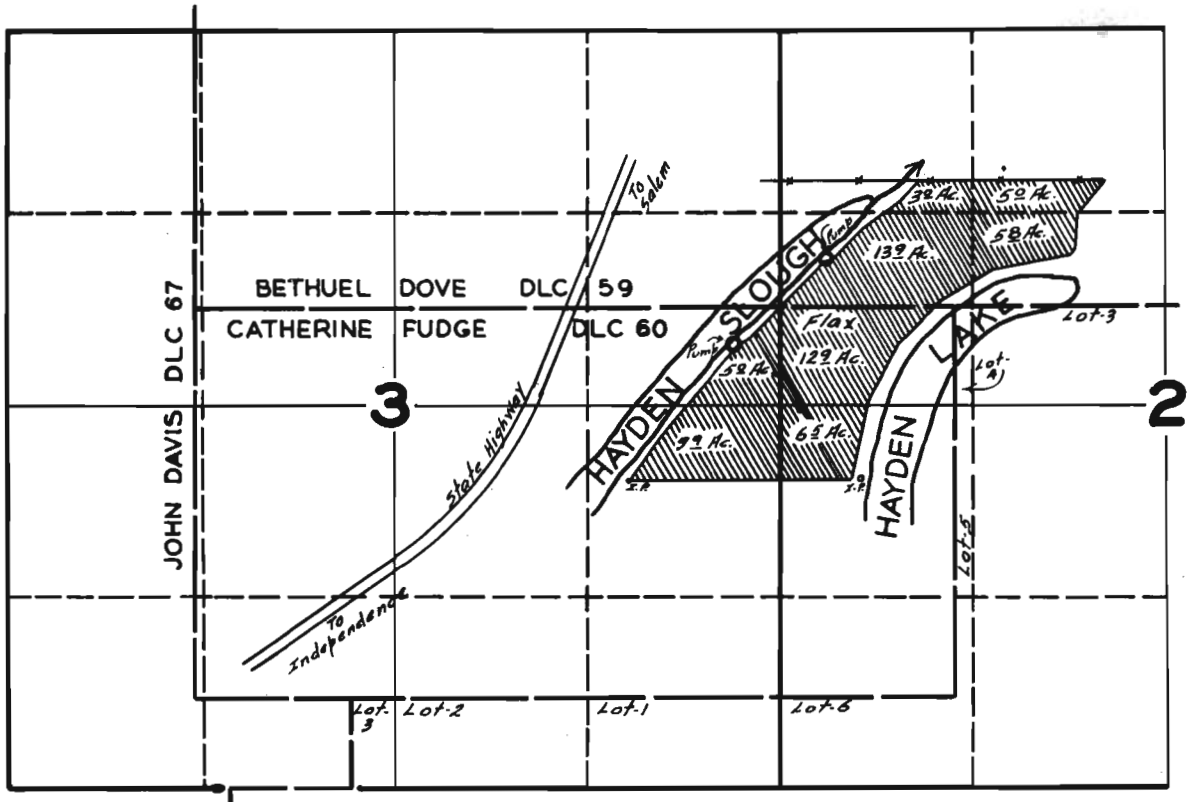

## FINAL PROOF SURVEY UNDER

Application No. 19521 Permit No. 15113

IN FAVOR OF

**CHARLES A. EVANS**

Surveyed SEPT. 14 1944, by *[Signature]*