


T.5S. R.3E.W.M.

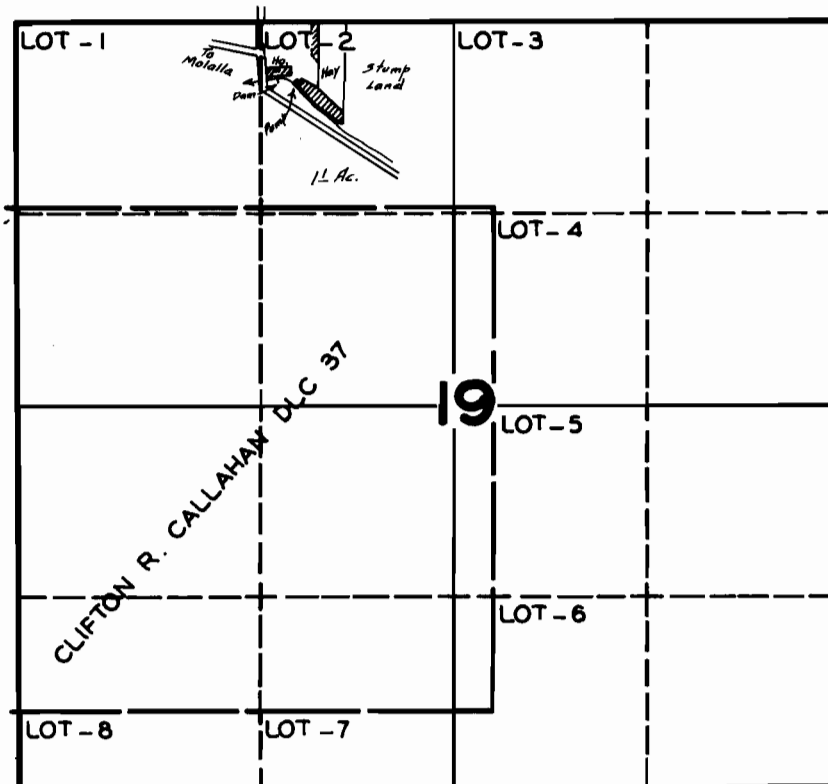

**FINAL PROOF SURVEY
UNDER**

Application No. 19572 Permit No. 15154

W. B. FRICKEY
V. B. FRICKEY

Surveyed SEPT. 5, 1944, by *[Signature]*