


T.1&2S.R.9W.W.M.

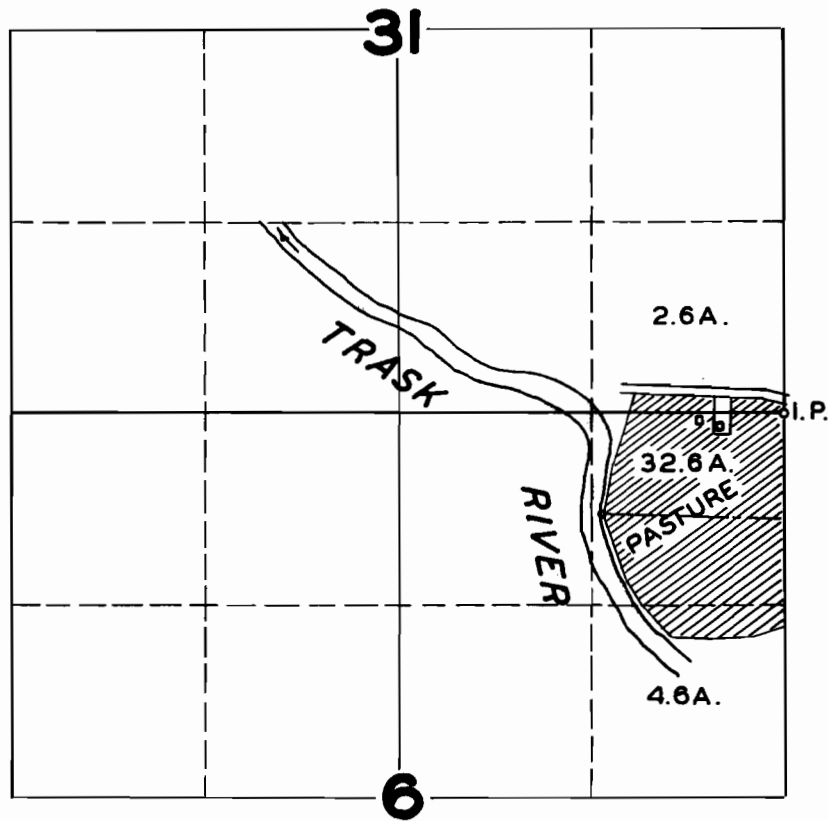

— CORRECTION MAP —
6-7-49


FINAL PROOF SURVEY UNDER

Application No. **19600** Permit No. **15187**
IN NAME OF

STEPHEN STEINER

Surveyed **AUG. 15, 1944**, by **JAS. E. BUNNELL**

T.2S. R.9W.W.M.

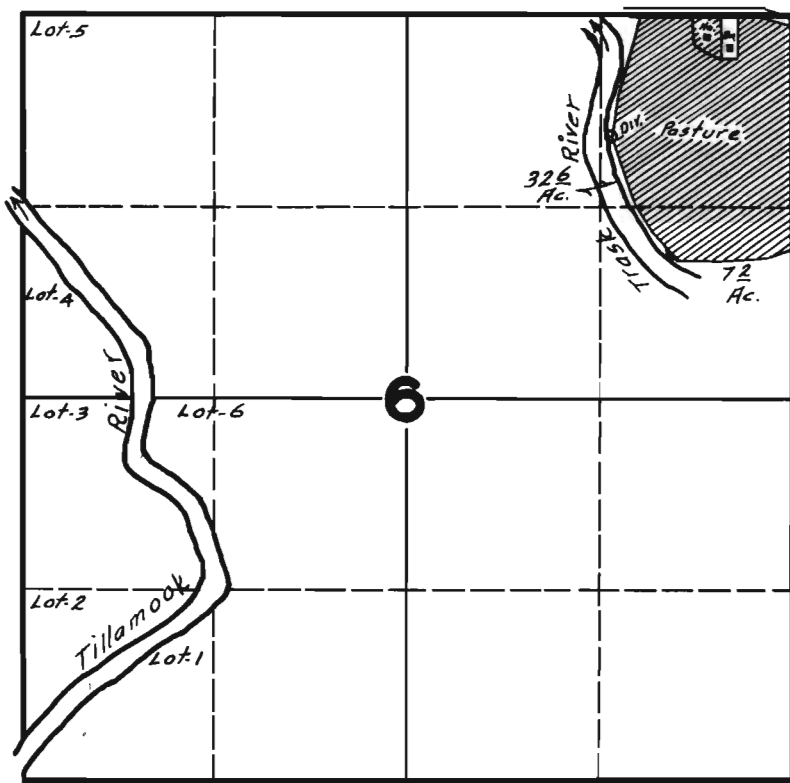

*See later map.
J.E.B.
6/7/49*

FINAL PROOF SURVEY UNDER

Location No. 19600 Permit No. 15187

IN NAME OF

STEPHEN STEINER

Surveyed AUG. 15, 1944, by *[Signature]*