


# T.7S. R.4W.W.M.

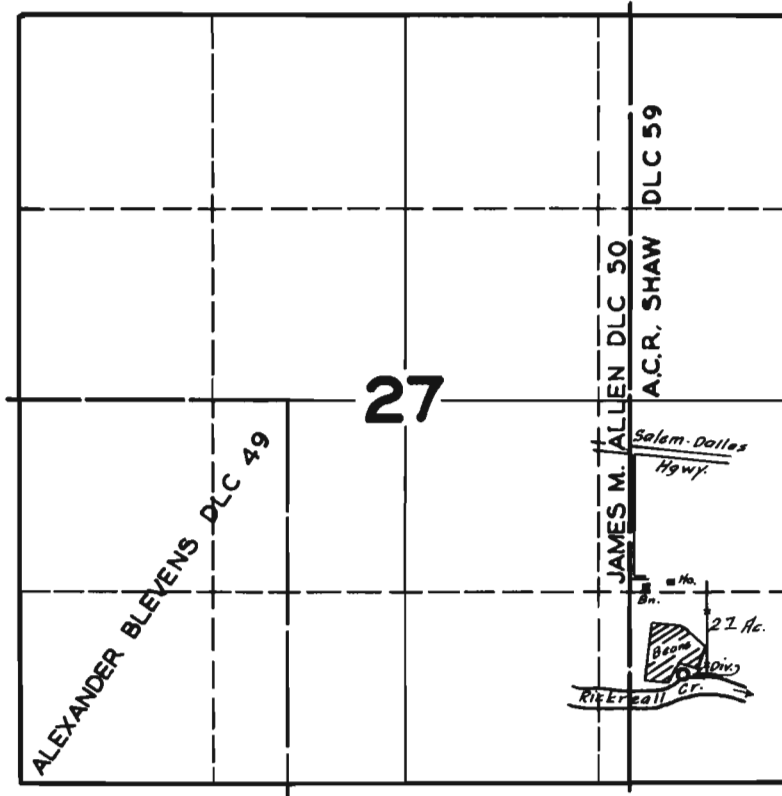

## FINAL PROOF SURVEY UNDER

Application No. 19633 Permit No. 15207

IN NAME OF

STANLEY D. WATERS

Surveyed JULY 21 1944, by

*[Handwritten Signature]*