


# T.10S. R.3&4.W. W.M.

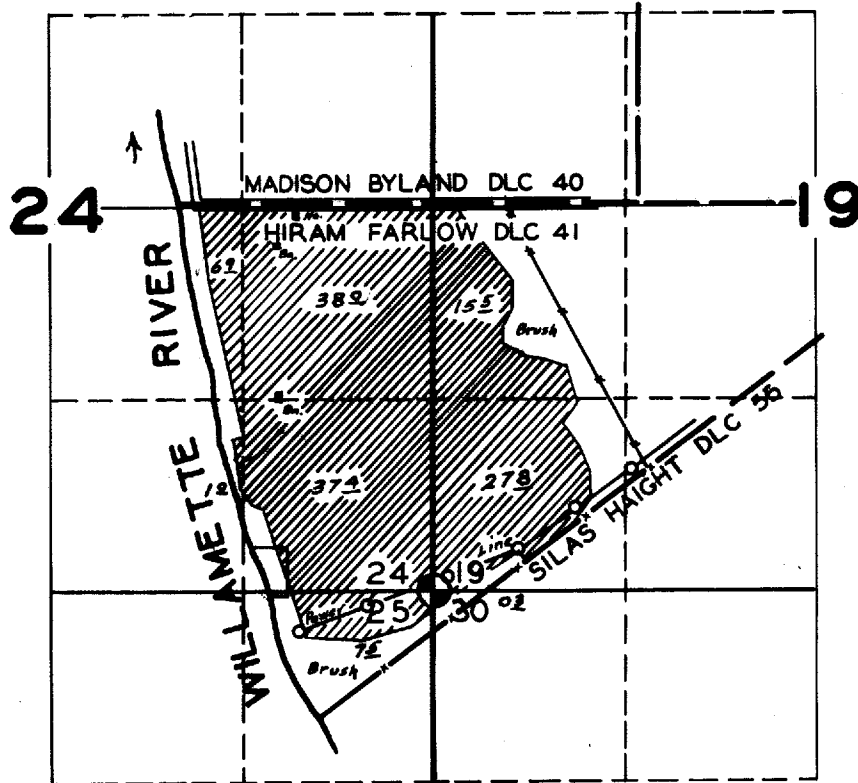

## FINAL PROOF SURVEY UNDER

Application No. 19641 Permit No. 15211

IN NAME OF

JAMES IVAN STEWART

Surveyed SEPT. 12 1944, by

*[Handwritten Signature]*