


T.4S. R.10W.W.M.

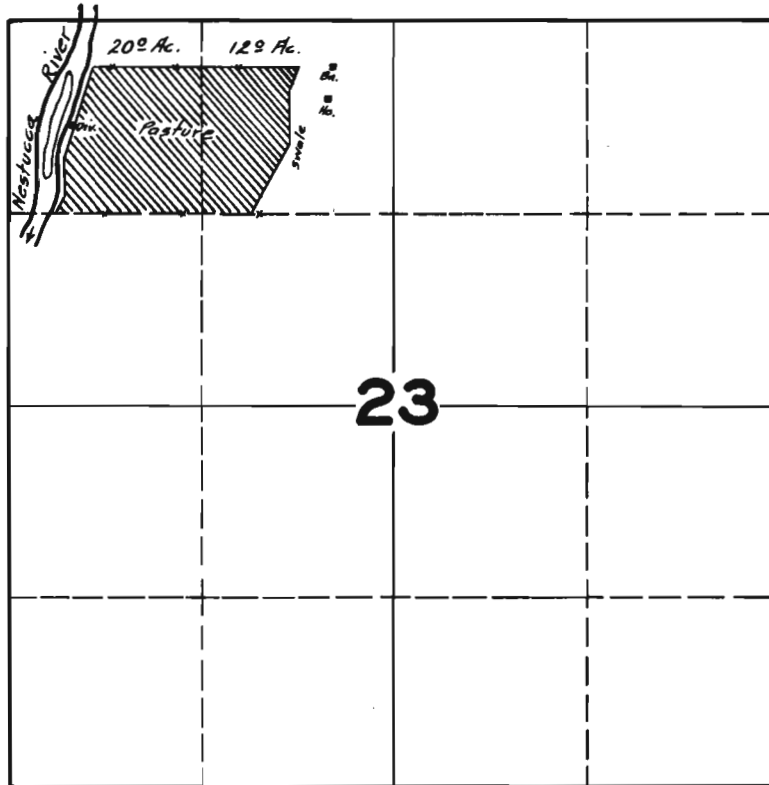

FINAL PROOF SURVEY UNDER

Application No. 19702 Permit No. 15280

IN NAME OF

LEON F. HANCOCK

Surveyed AUG. 16 1944, by

[Handwritten Signature]