


# T.5S. R.6W.W.M.

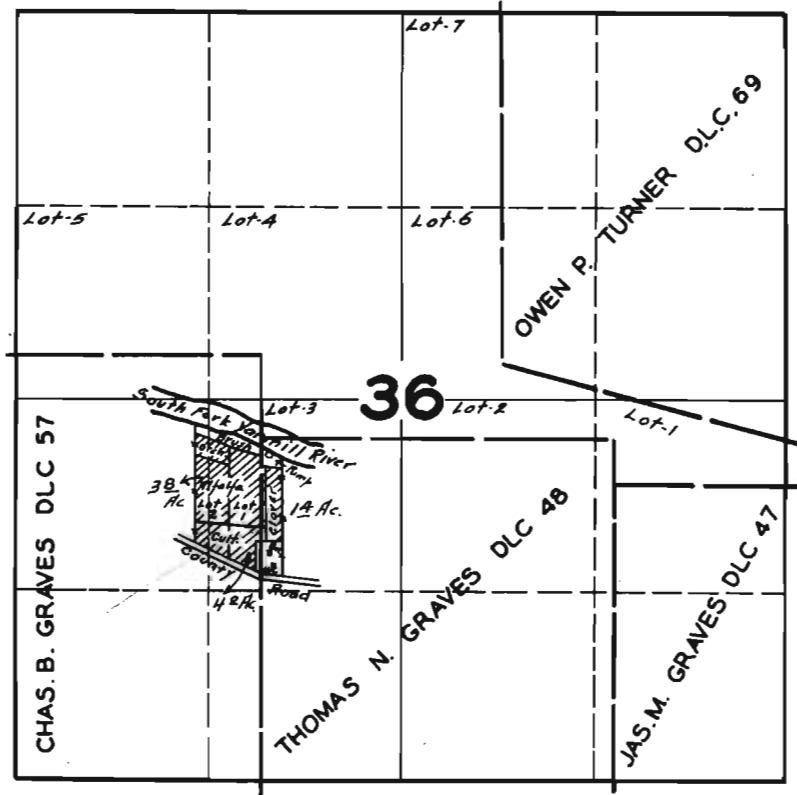

## FINAL PROOF SURVEY UNDER

Application No. 19738 Permit No. 15325

IN NAME OF

J. F. BAIRD

Surveyed JULY 6, 1944, by *J. F. Baird*