


T.3S. R.3W.W.M.

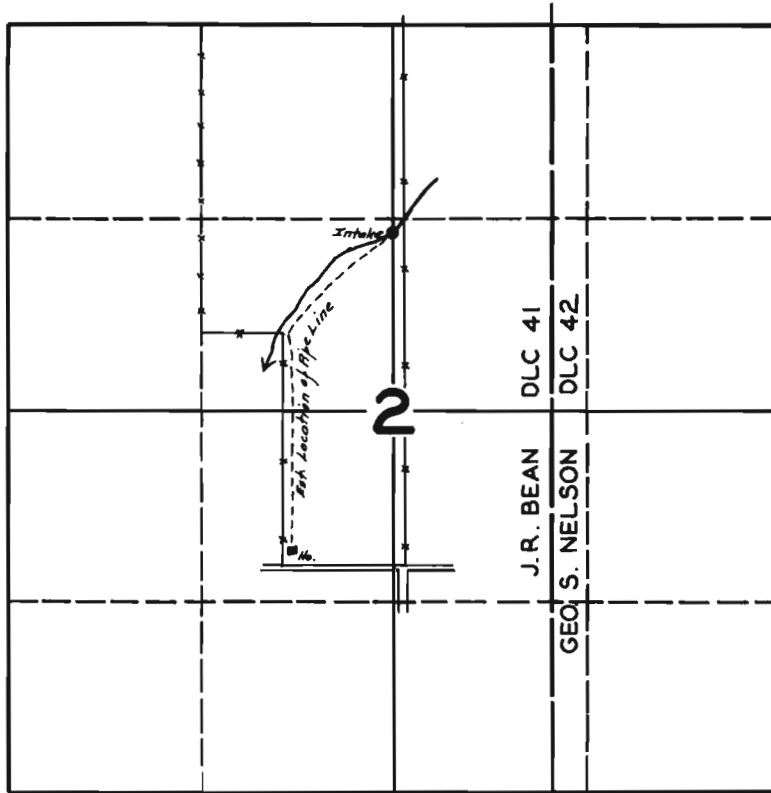

FINAL PROOF SURVEY UNDER

Application No. 19774 Permit No. 15357

IN NAME OF

ALMA R. PIER

Surveyed JULY 10, 1944, by