


T.7S. RIW. W.M.

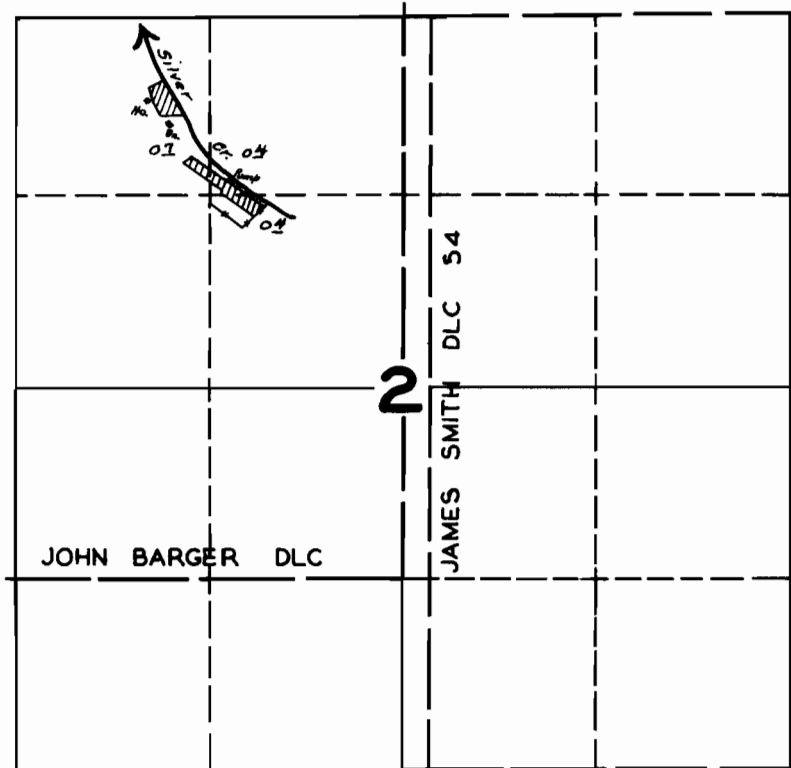

FINAL PROOF SURVEY UNDER

Application No. 19841 Permit No. 15411

IN NAME OF
D.L. COLL

Surveyed JUNE 8 1944, by *John B. Russell*