


T.5S. R.3W.W.M.

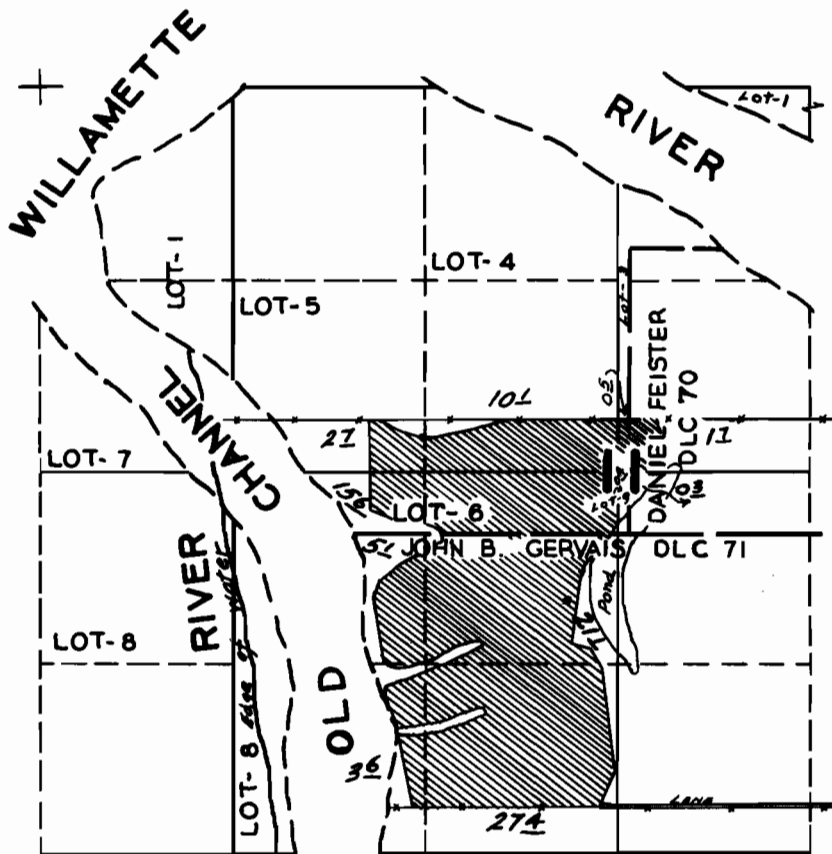

FINAL PROOF SURVEY

UNDER

Application No. 19854 Permit No. 15433

IN NAME OF

JAS. F. MAHONY

Surveyed AUG. 24 1944, by *J. F. Mahony*