


T.7S. R.IW.W.M.

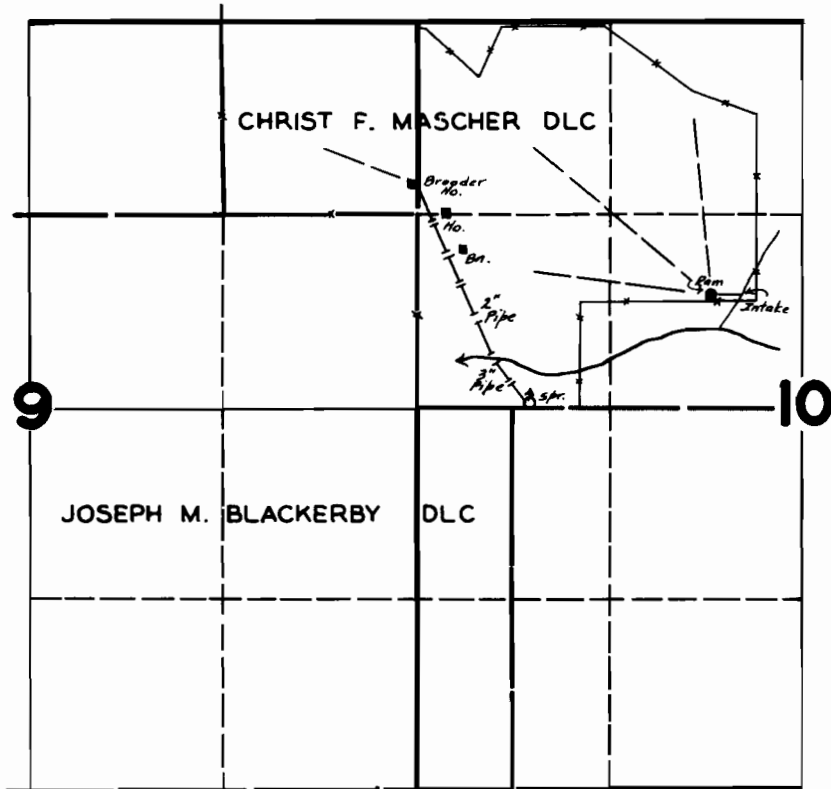

FINAL PROOF SURVEY

UNDER

Application No. 19867 Permit No. 15444

IN FAVOR OF

R. STADELI

Surveyed DEC. 16, 1944 by