


T.3S. R.3E.W.M.

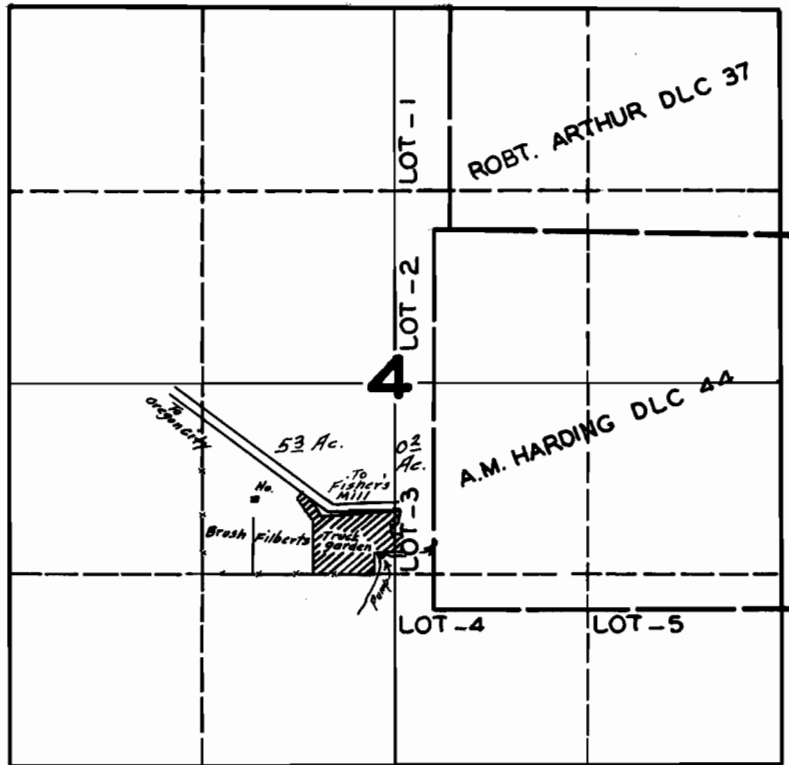

FINAL PROOF SURVEY UNDER

Application No. 19875 Permit No. 15451

IN NAME OF

PAUL SCHEEFE

Surveyed AUG. 28 1944, by [Signature]