T.5S. R.2E.W.M.

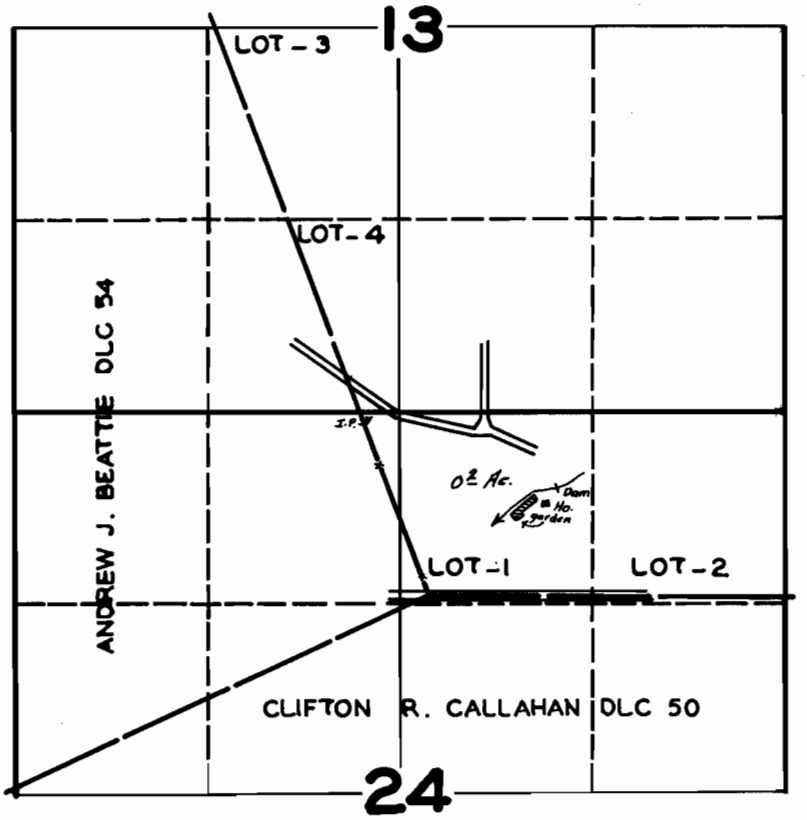

FINAL PROOF SURVEY

UNDER

Application No. 19915 Permit No. 15490

IN NAME OF

EDWIN WEIDMAN

Surveyed SEPT. 5 1944, by James B. Russell

1944 - G