


T. 4S. R. 3W. W.M.

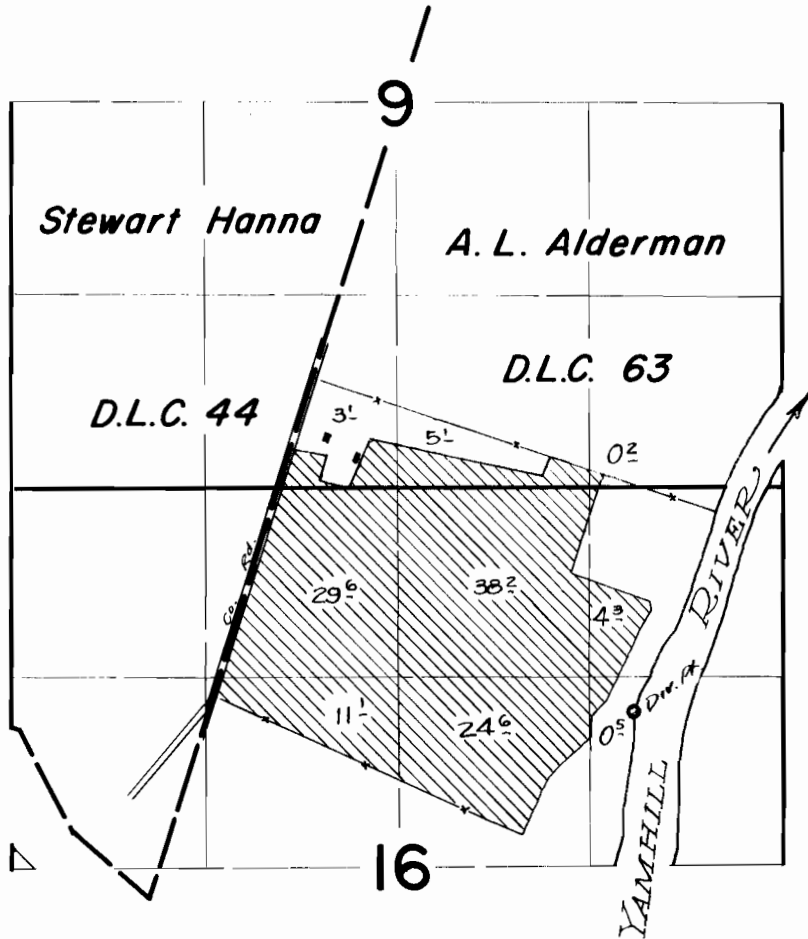

FINAL PROOF SURVEY
UNDER

Application No. 19997 Permit No. 15559
IN NAME OF

E. MILES MAXWELL

Surveyed August 24 1944, by James Bunnell.