


T.3S. R.2W.W.M.

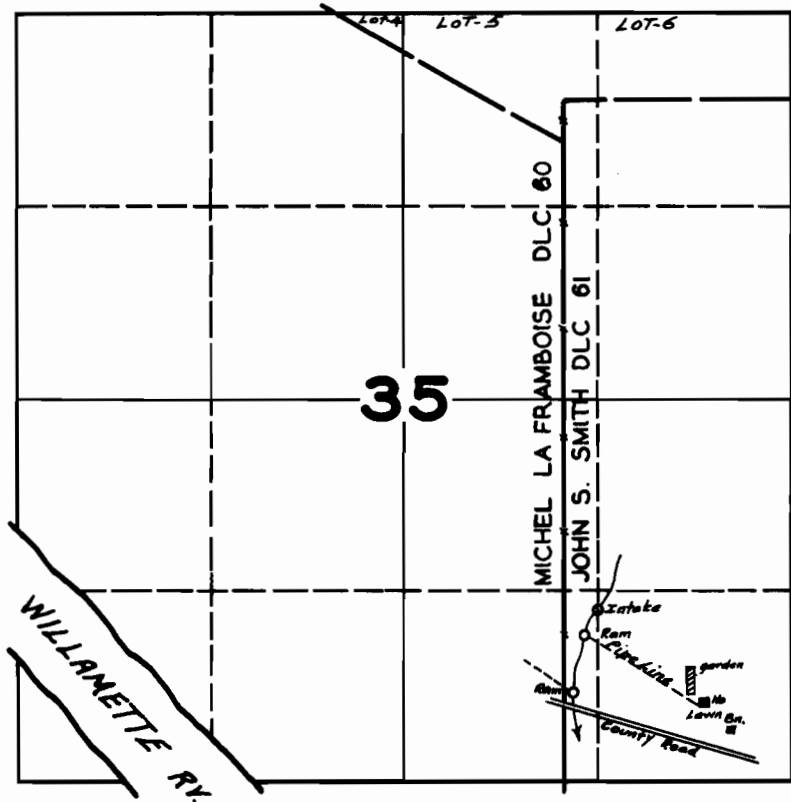

FINAL PROOF SURVEY

UNDER

Application No. 20018 Permit No. 15589

IN NAME OF

SYBIL BROWN

Surveyed JULY 3, 1944, by [Signature]