


T. 1 S. R. 4 W. W. M.

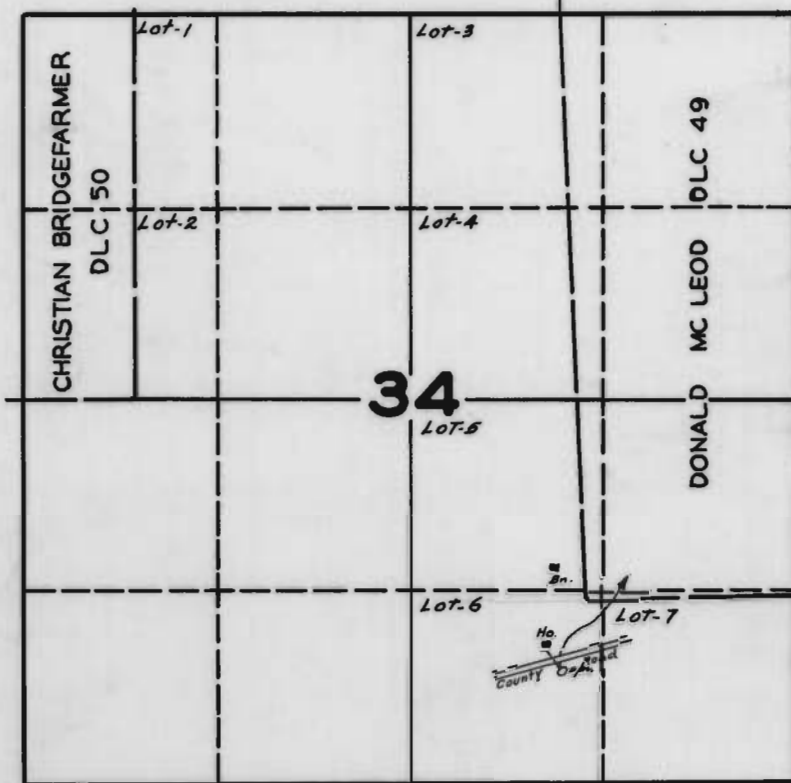

**FINAL PROOF SURVEY**  
UNDER

Application No. 20050 Permit No. 15616

IN NAME OF

GEORGE H. BEELE

Surveyed JULY 24 1944, by

*[Handwritten Signature]*