


T.3S. R.5W. W.M.

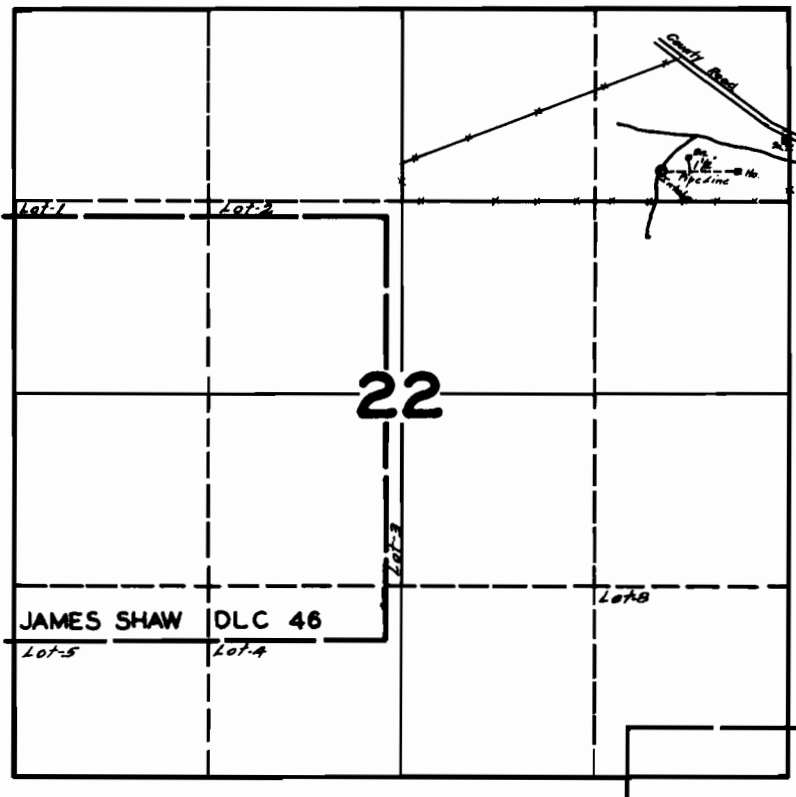

FINAL PROOF SURVEY UNDER

Application No. 20058 Permit No. 15623

IN NAME OF
R. W. FORBES

Surveyed JUNE 27 1944, by J. L. Burnell