


T.3S. R.5W.W.M.

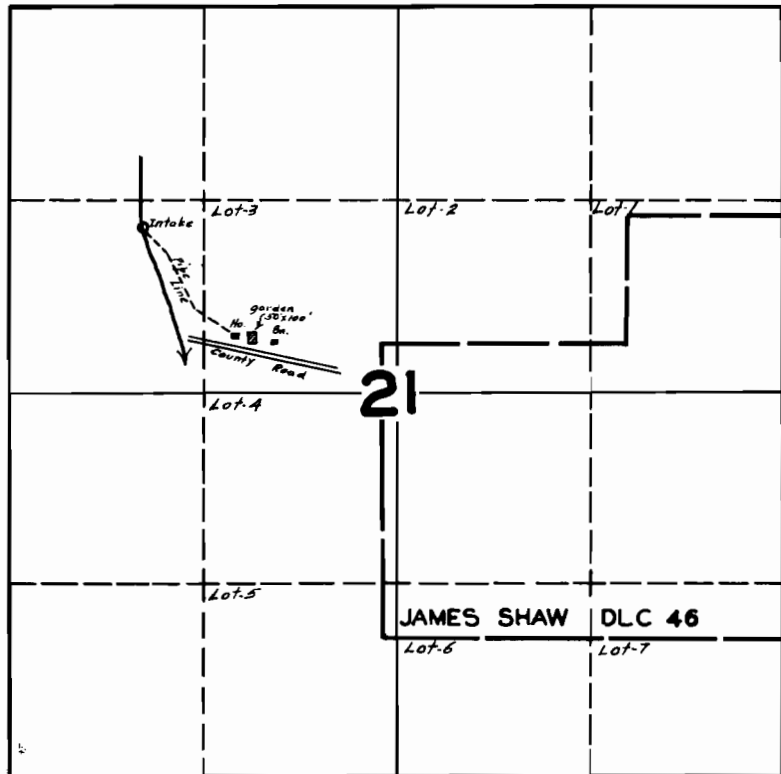

FINAL PROOF SURVEY
UNDER

Application No. 20065 Permit No. 15628

IN NAME OF

ALBERT BACHMANN JR.

Surveyed JUNE 27 1944, by [Signature]