


T.4N. R.1W.W.M.

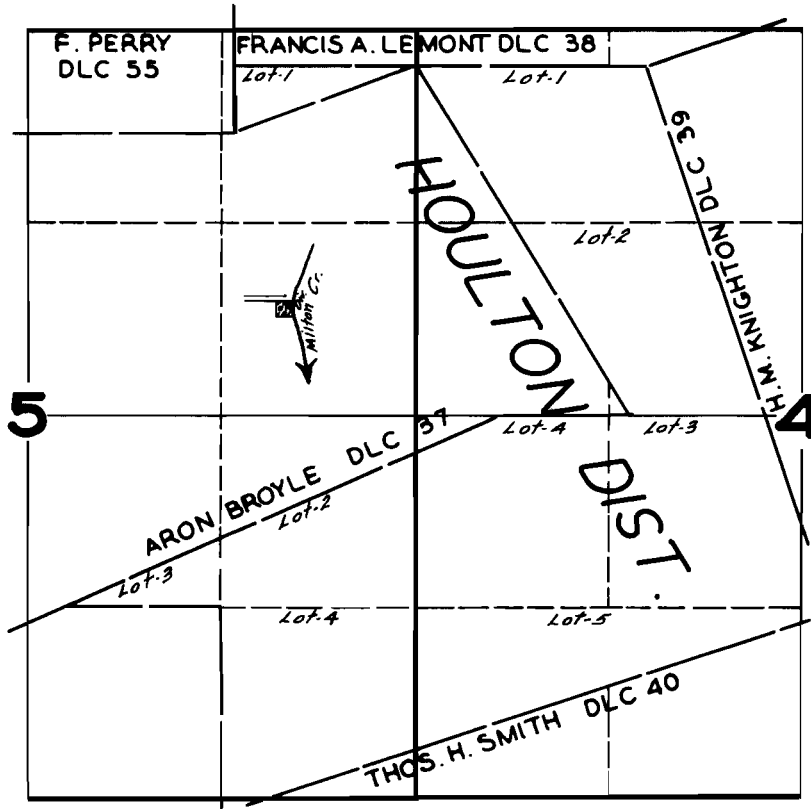

**FINAL PROOF SURVEY  
UNDER**

Application No. 20126 Permit No. 15689

IN NAME OF

RALPH R. BUTTS

Surveyed AUG. 7, 1944, by [Signature]