


T. IS. R. IOW. W. M.

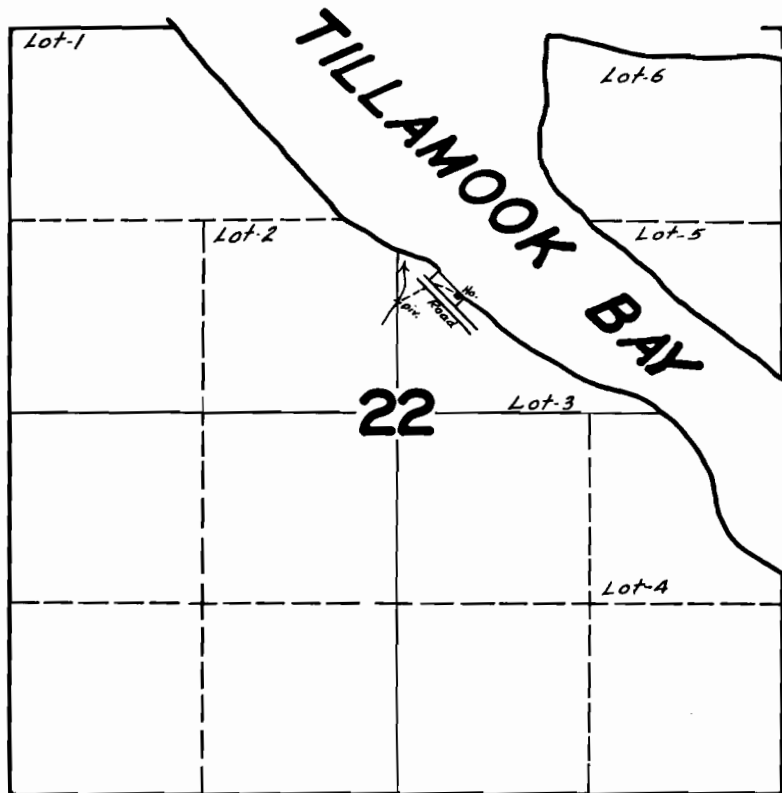

FINAL PROOF SURVEY UNDER

Application No. 20203 Permit No. 15754

IN FAVOR OF

BEN S. POWELL

Surveyed AUG. 14 1944, by *James B. Russell*