


T.9S. R.4W.W.M.

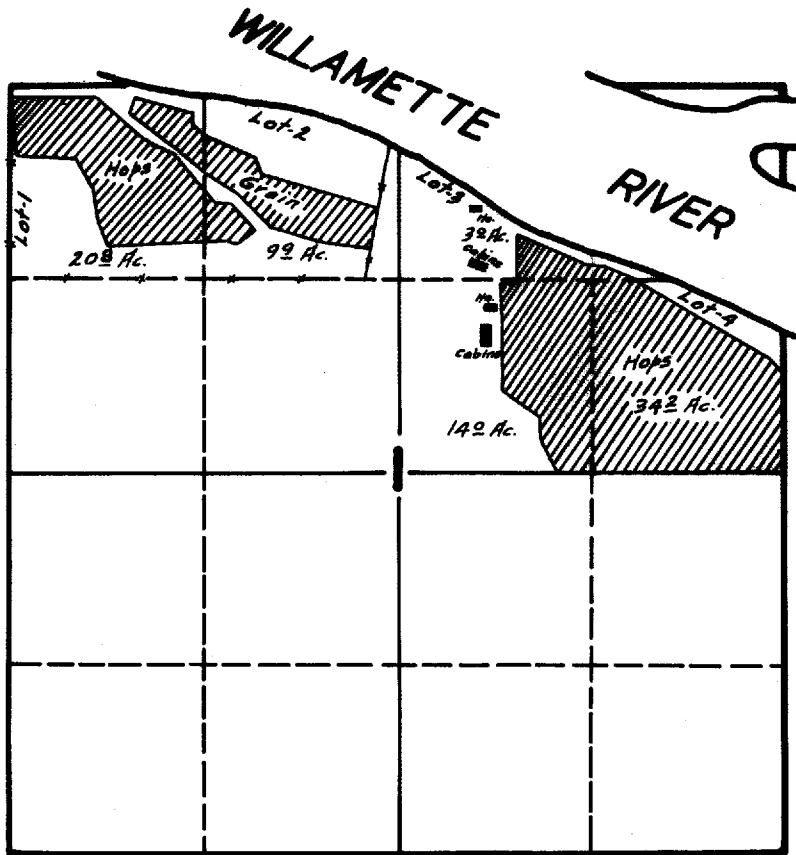

**FINAL PROOF SURVEY
UNDER**

Application No. 19324 Permit No. 14904

IN NAME OF

S. J. HOOVER & SON

Surveyed SEPT. 13 1944 by [Signature]