


# T 6 S. R I W. W. M.

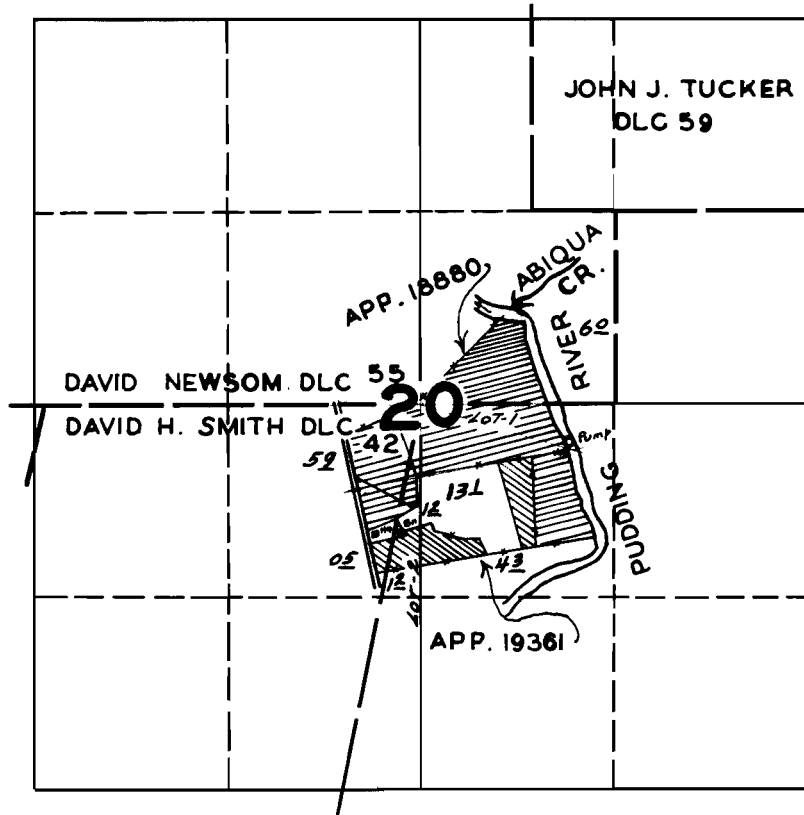

## FINAL PROOF SURVEY

UNDER

Application No. 18880 Permit No. 14385  
19361 14945

IN NAME OF

**JOHN H. FICK**

Surveyed JUNE 9 1944, by