


T. 8 S., R. 3 W. W.M.

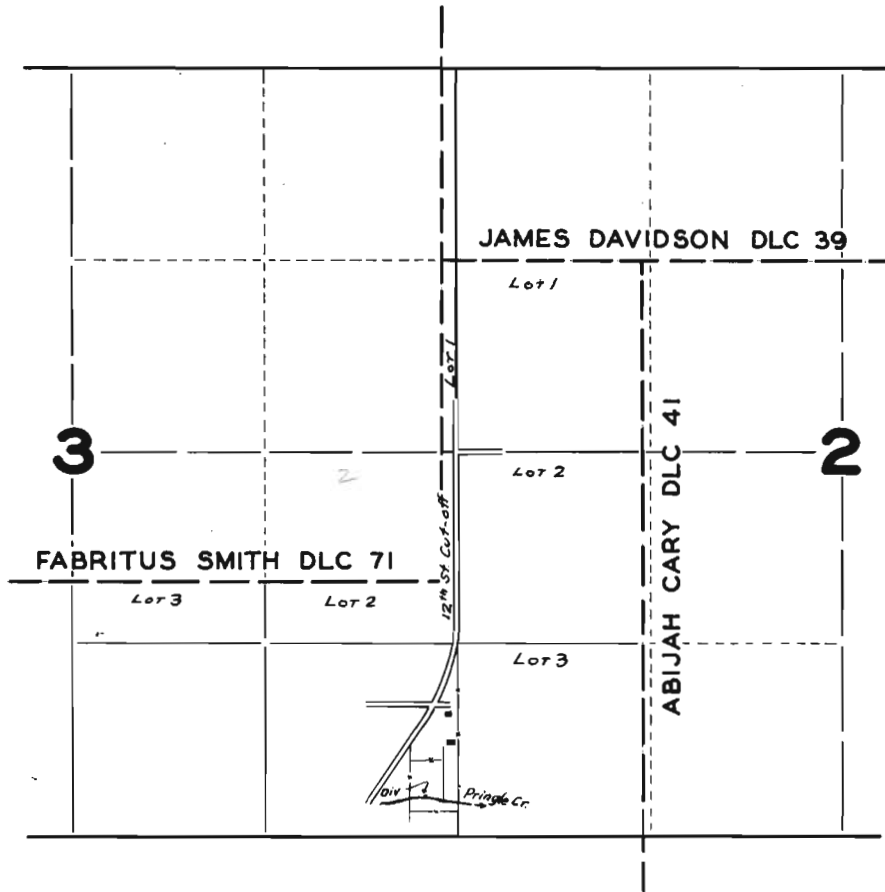

FINAL PROOF SURVEY  
UNDER

Application No. 19785 Permit No. 15366  
IN NAME OF

*Ralph I. Gifford*

Surveyed July 26 1943, by *Geo. W. Mademan*