T.4S. R.4W.W.M.

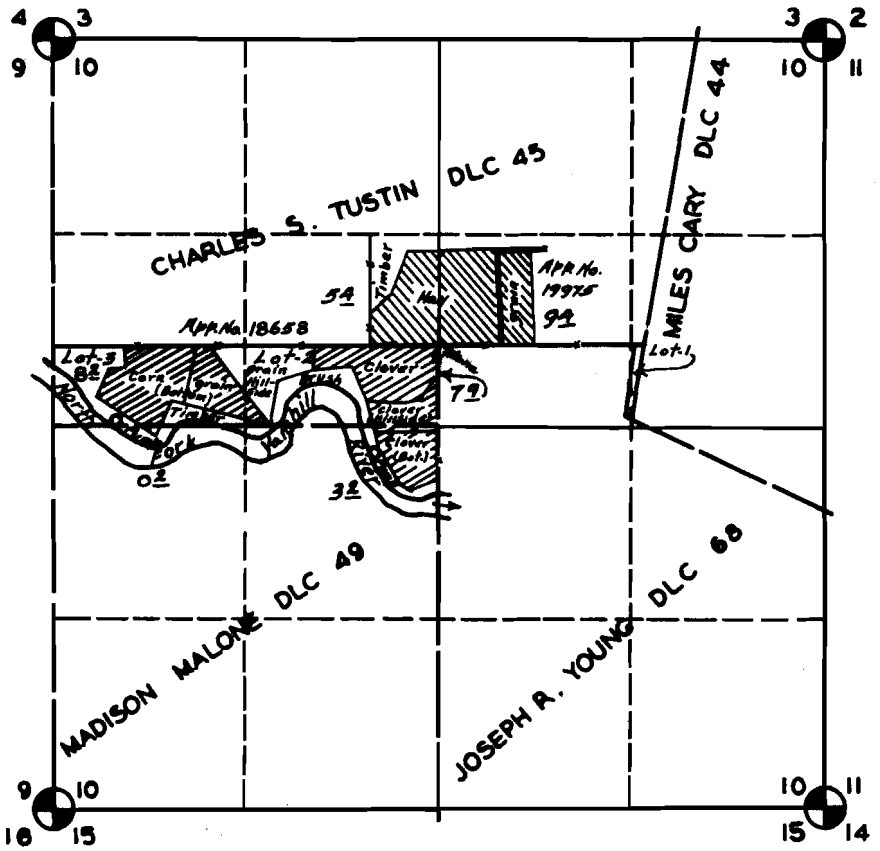

FINAL PROOF SURVEY

UNDER

Application No. 18658 19975 Permit No. 14290 15542

IN NAME OF

FRED AEBI

Surveyed JUNE 26 1944, by [illegible]

1944-C