


# T.3S. R.5W.W.M.

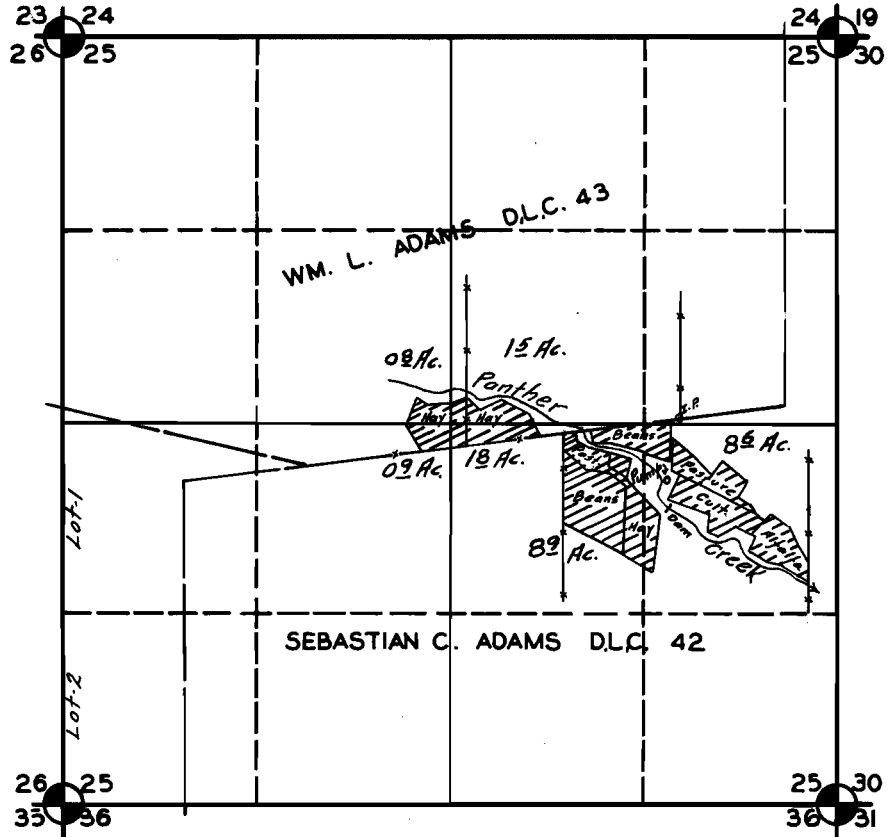

## FINAL PROOF SURVEY UNDER

Application No. 18131 Permit No. 13779

IN NAME OF

UNITED STATES OF AMERICA

Surveyed JUNE 28 1944, by

*J. L. Sumrell*