


U-181  
C-15174

T.4N.R.27E.W.M.

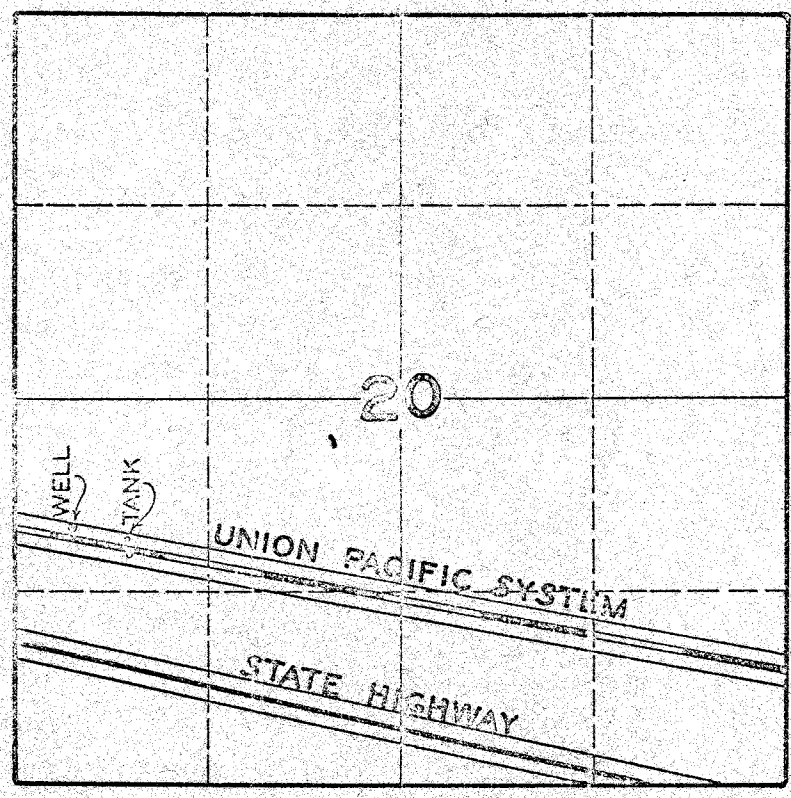

**FINAL PROOF SURVEY**  
UNDER

Application No. U-199 Permit No. U-181

IN NAME OF

ORE.-WASH. R.R. & NAVIGATION CO. AND ITS LESSEE-UNION PACIFIC R.R. CO.

Surveyed JUNE 25 1946 by

A large, stylized handwritten signature in black ink, appearing to read 'J. H. Russell', is written over the text 'Surveyed' and extends across the bottom of the page.