


# T. 11 S. R. 43 E. W. M.

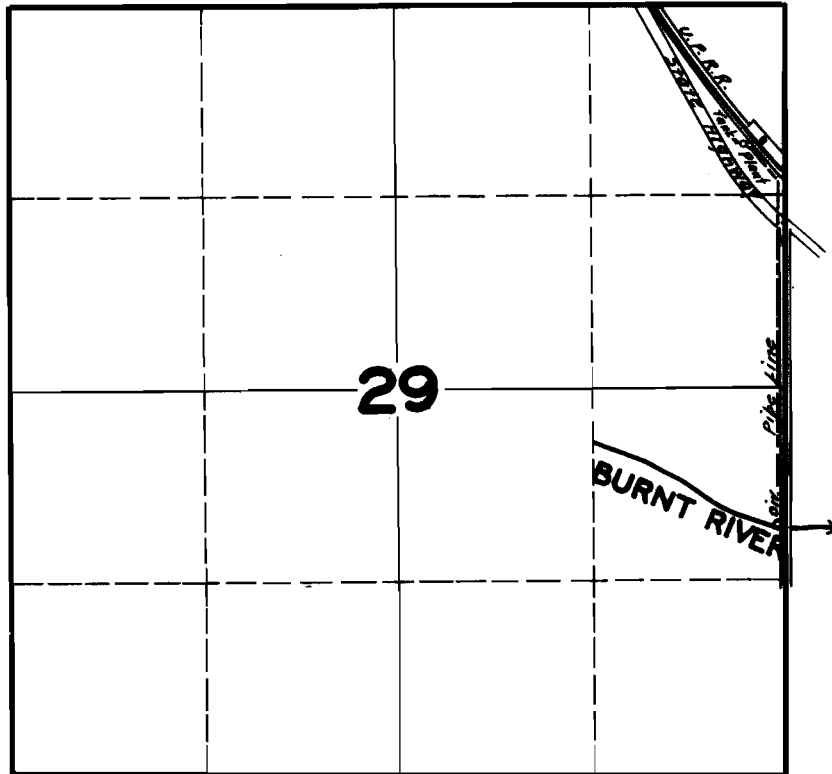

## FINAL PROOF SURVEY UNDER

Application No. 19583 Permit No. 15079

IN NAME OF

UNION PACIFIC RAILROAD COMPANY-ORE.-WASH. R.R. & NAVIGATION COMPANY

Surveyed SEP. 27, 1946, by *John R. Russell*