



Township 15.

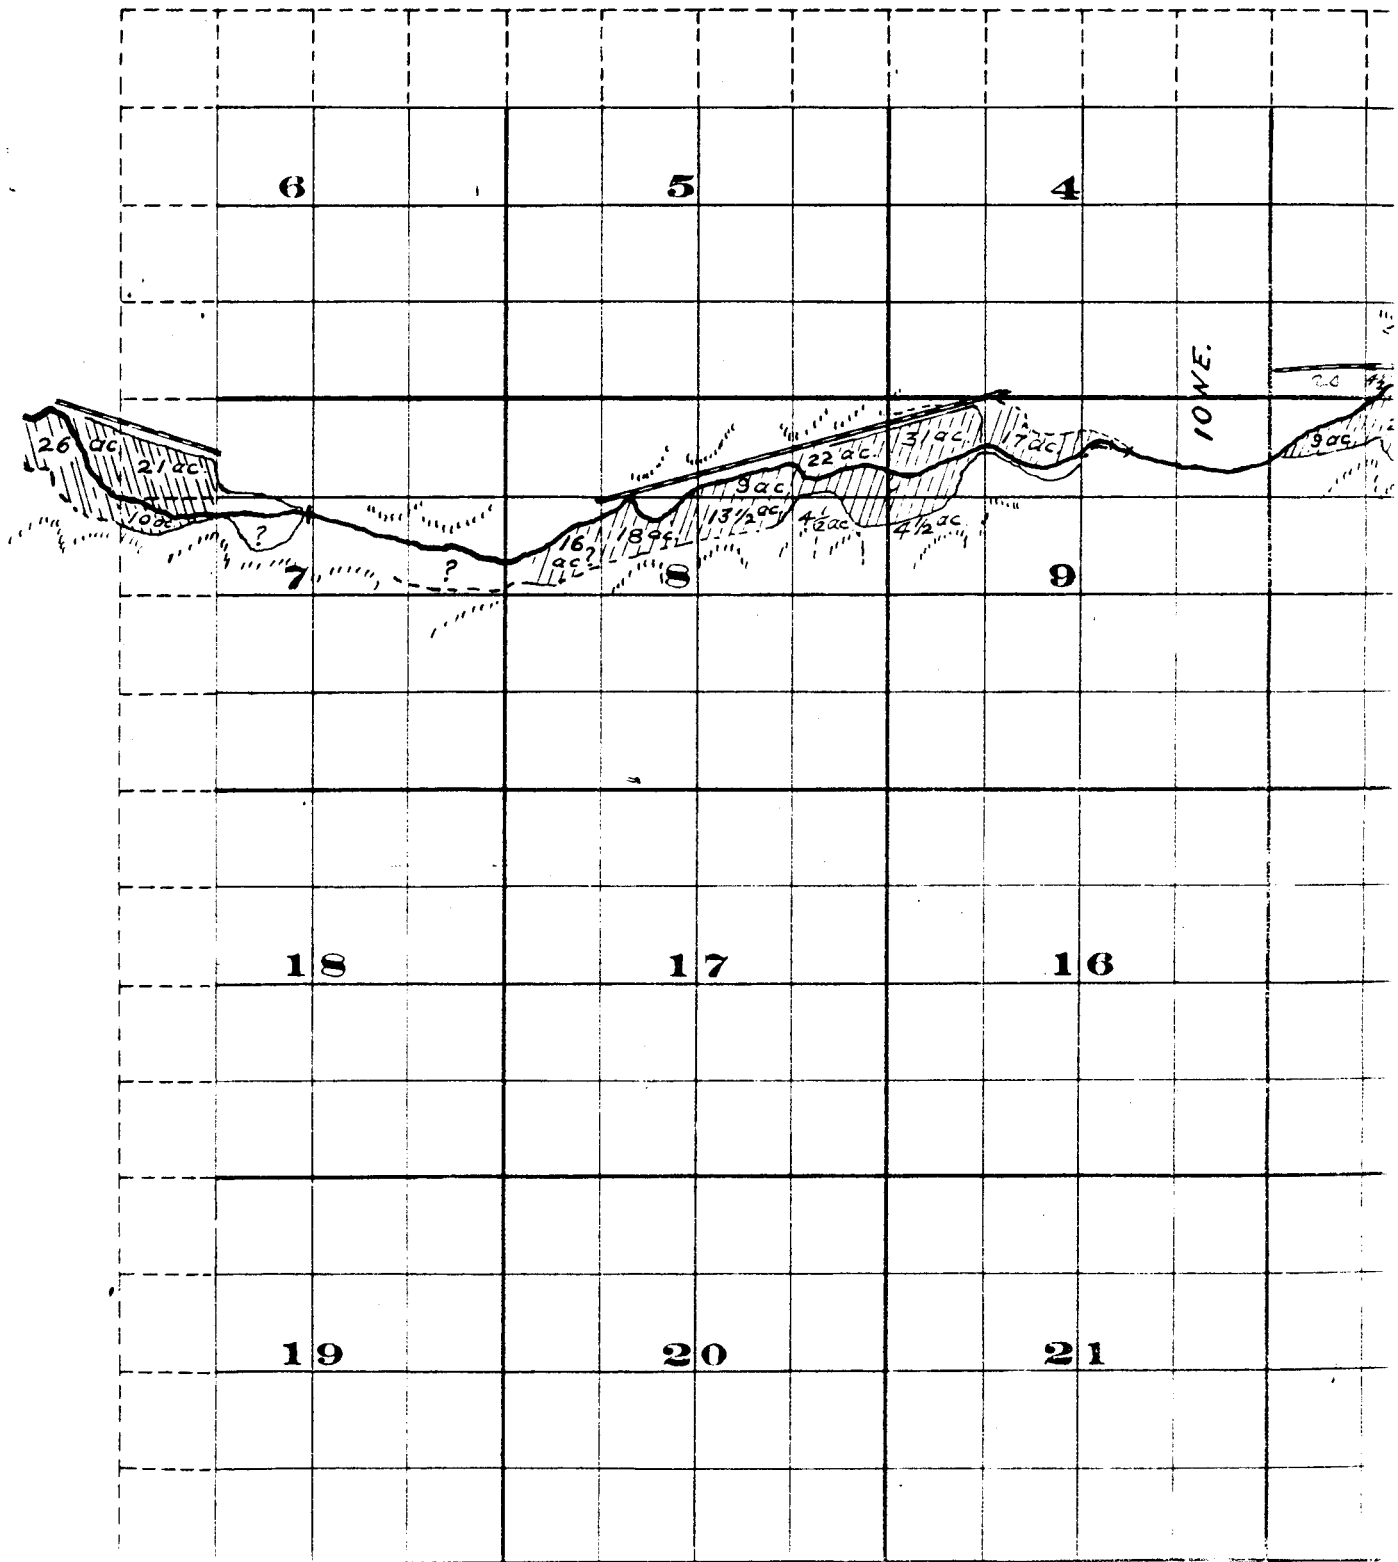

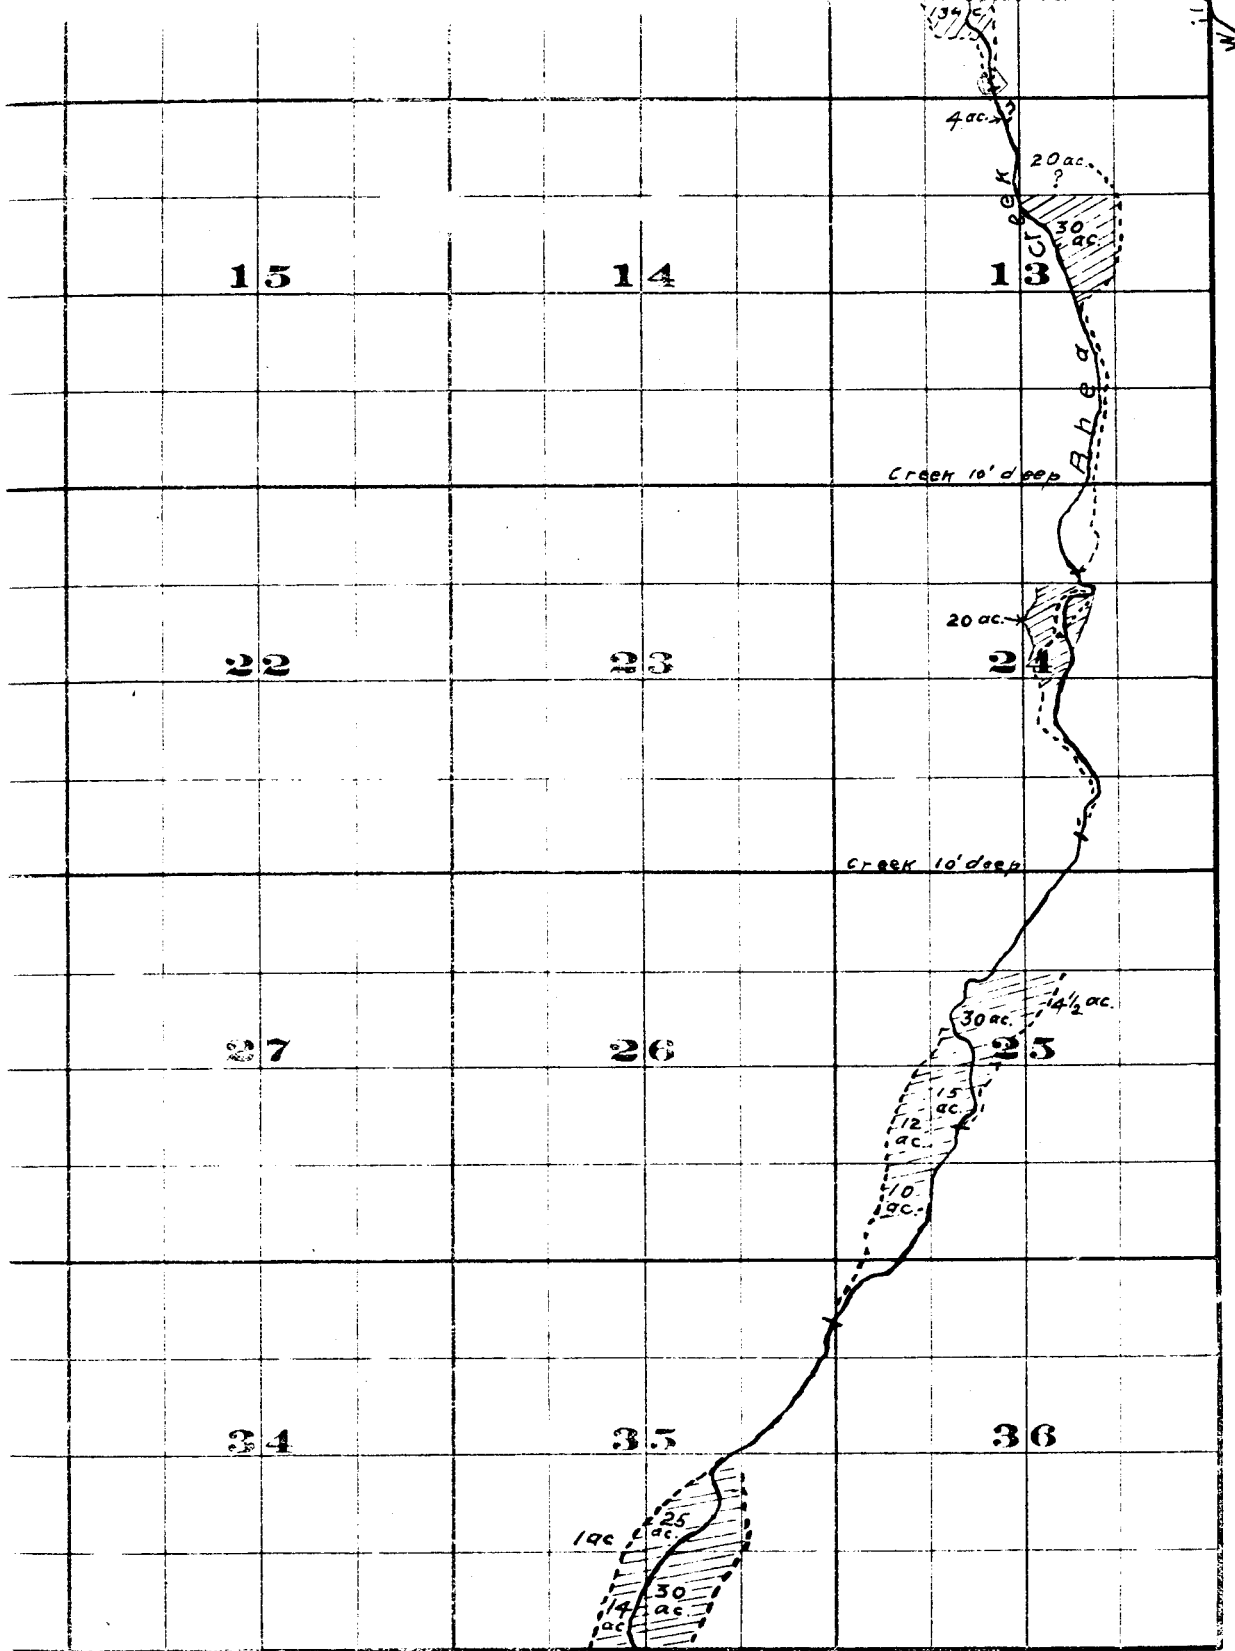

FROM OFFICE OF THE STATE ENGINEER, SALEM, OREGON

Willow Creek Adjudication.

1 S. 24 E

R. 1 W. 3 E