


T.8S. R.6W.W.M.

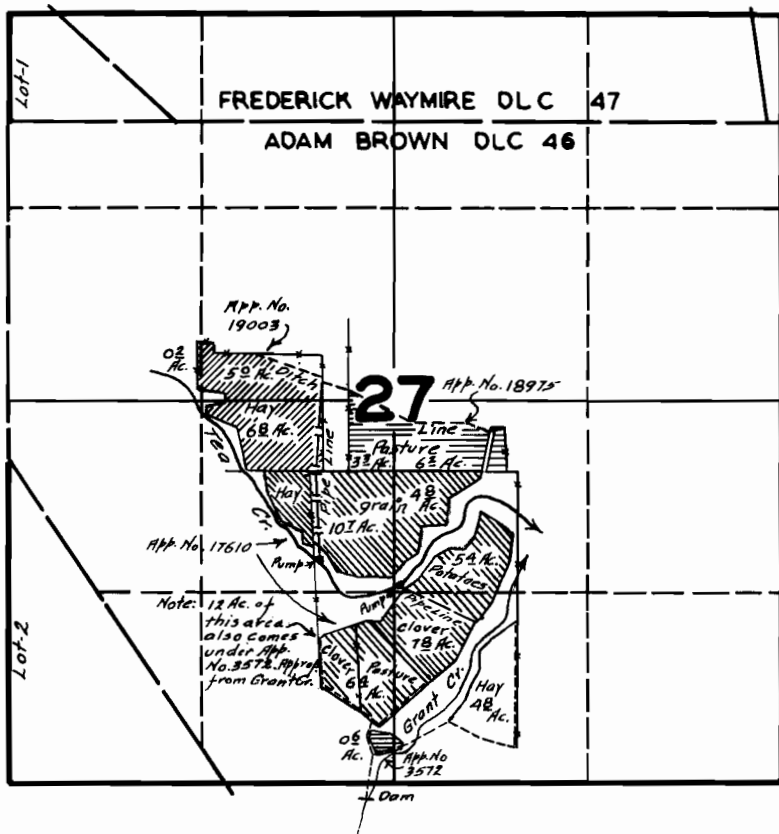

FINAL PROOF SURVEY

17610 UNDER 13414
 18975 14599
 Application No. 19003 Permit No. 14616

IN FAVOR OF

GEO. E. MAGGINITIE

Surveyed AUG. 4, 1944, by *J. E. Russell*