


**T.4S. R.2W.W.M.**

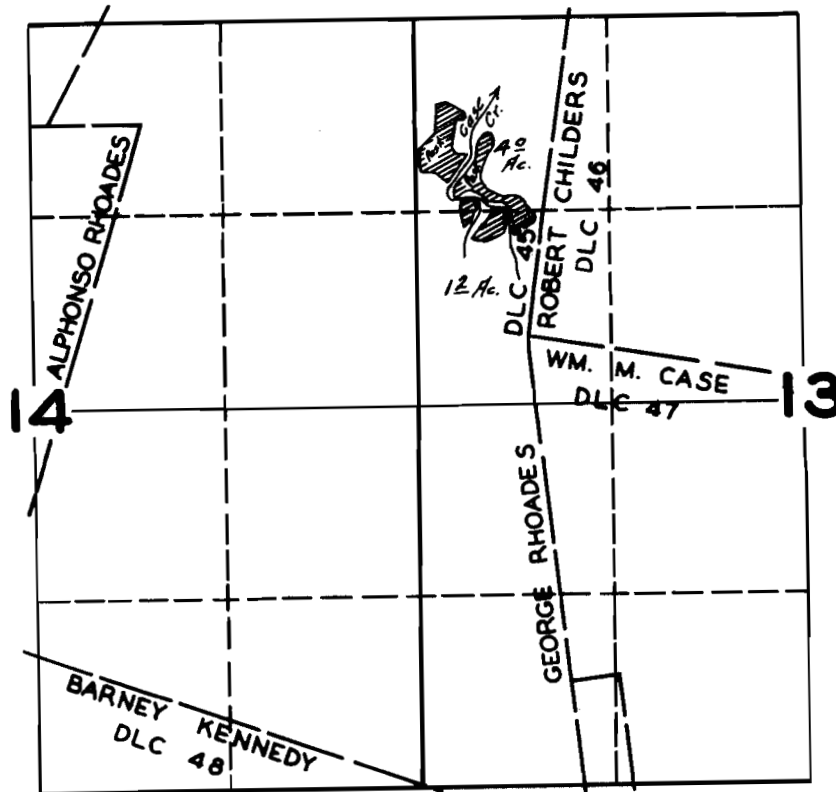

**FINAL PROOF SURVEY  
UNDER**

Application No. 18487 Permit No. 14154

IN NAME OF

**WILLIAM F. COLEMAN**

Surveyed JUNE 15 1944, by

*[Signature]*