


T.7S. R.4W.W.M.

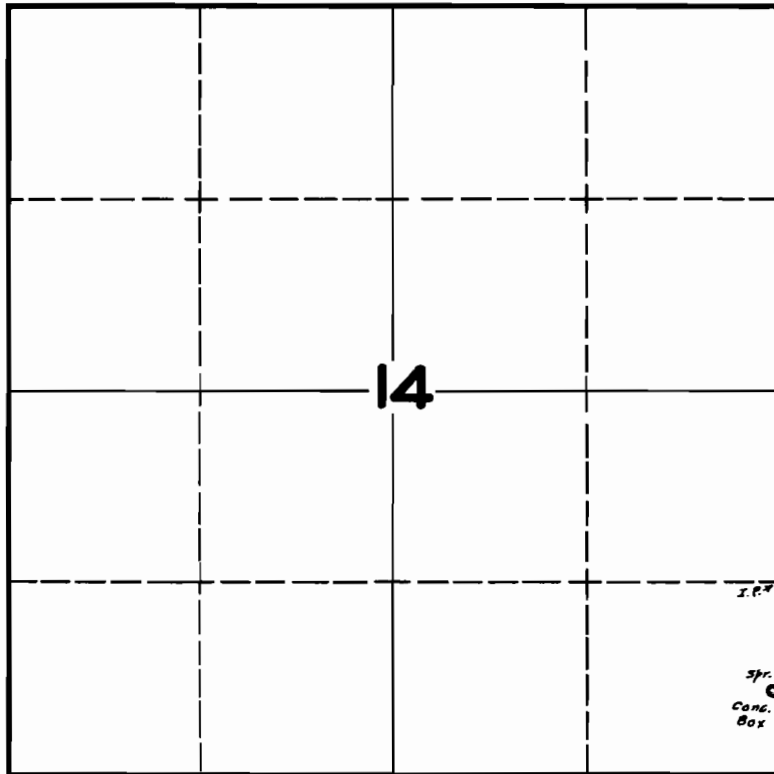

FINAL PROOF SURVEY

UNDER

Application No. 18628 Permit No. 14263

IN NAME OF

ROBT. L. ADAMS & ERVIN H. SIMMONS

Surveyed JULY 20 1944, by *[Signature]*