


# T.8S. R.6W.W.M.

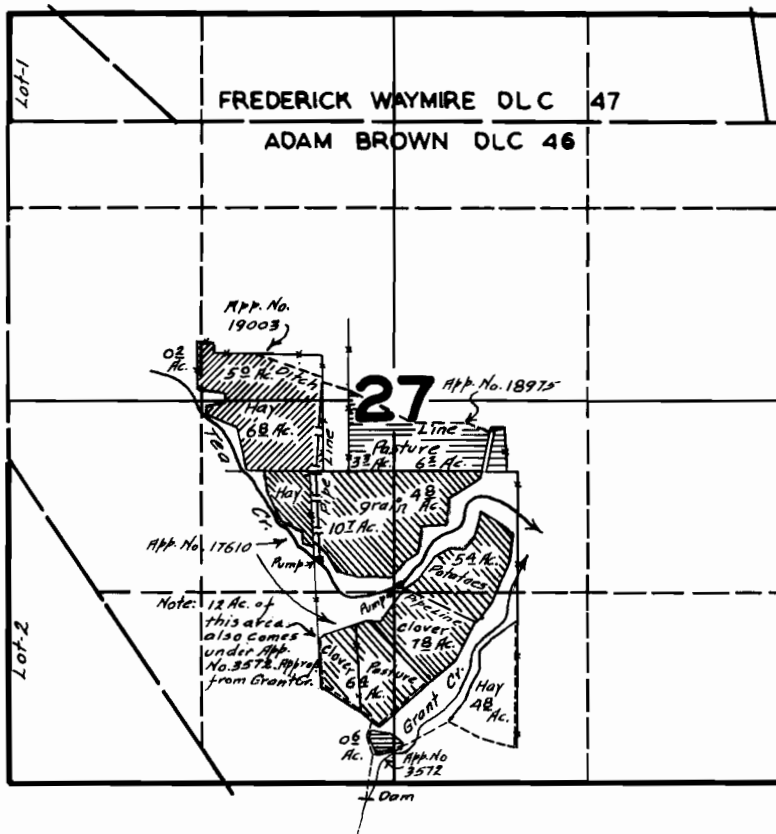

## FINAL PROOF SURVEY

17610 UNDER 13414  
 18975 14599  
 Application No. 19003 Permit No. 14616

IN FAVOR OF

GEO. E. MAGGINITIE

Surveyed AUG. 4, 1944, by *J. E. Russell*