


T.4S. R.5W.W.M.

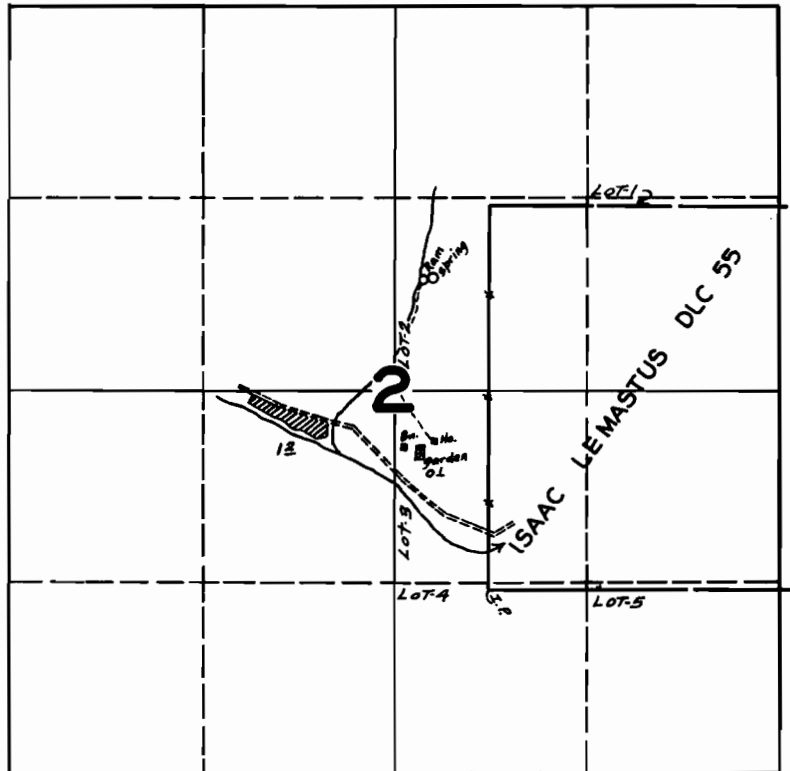

FINAL PROOF SURVEY UNDER

Application No. 19077 Permit No. 14672

IN NAME OF

B.A. KLIKS & LOUISE B. KLIKS

Surveyed JUNE 29 1944, by [Signature]