


T.7S. R.2E. W. M.

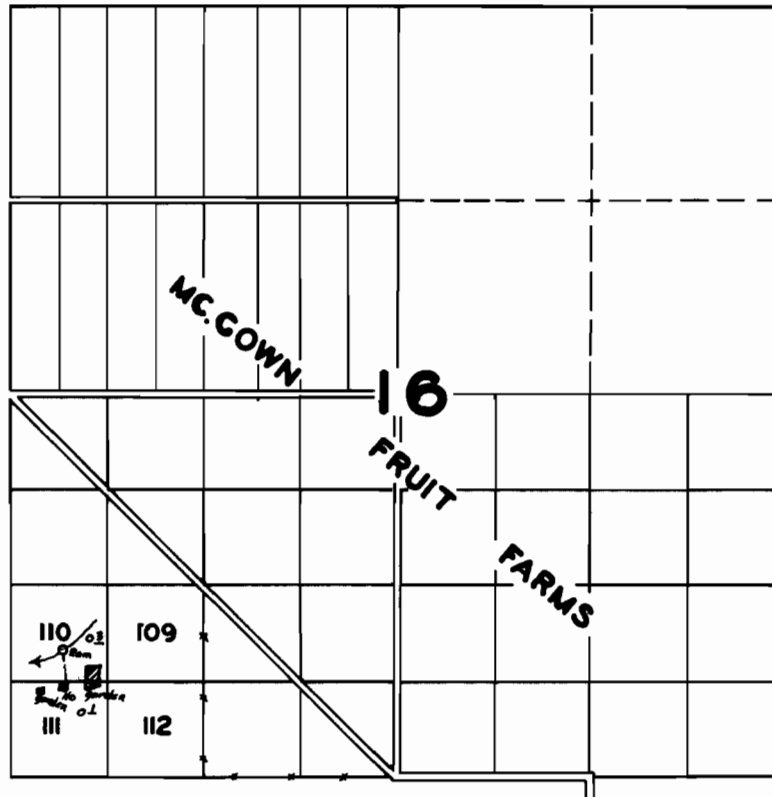

**FINAL PROOF SURVEY
UNDER**

Application No. 19412 Permit No. 15026

IN NAME OF

ADA EMMETT COLE

Surveyed JUNE 12 1944, by J. P. Darnell