


33

TOWNSHIP 33S, RANGE 2 W, W. M.

North

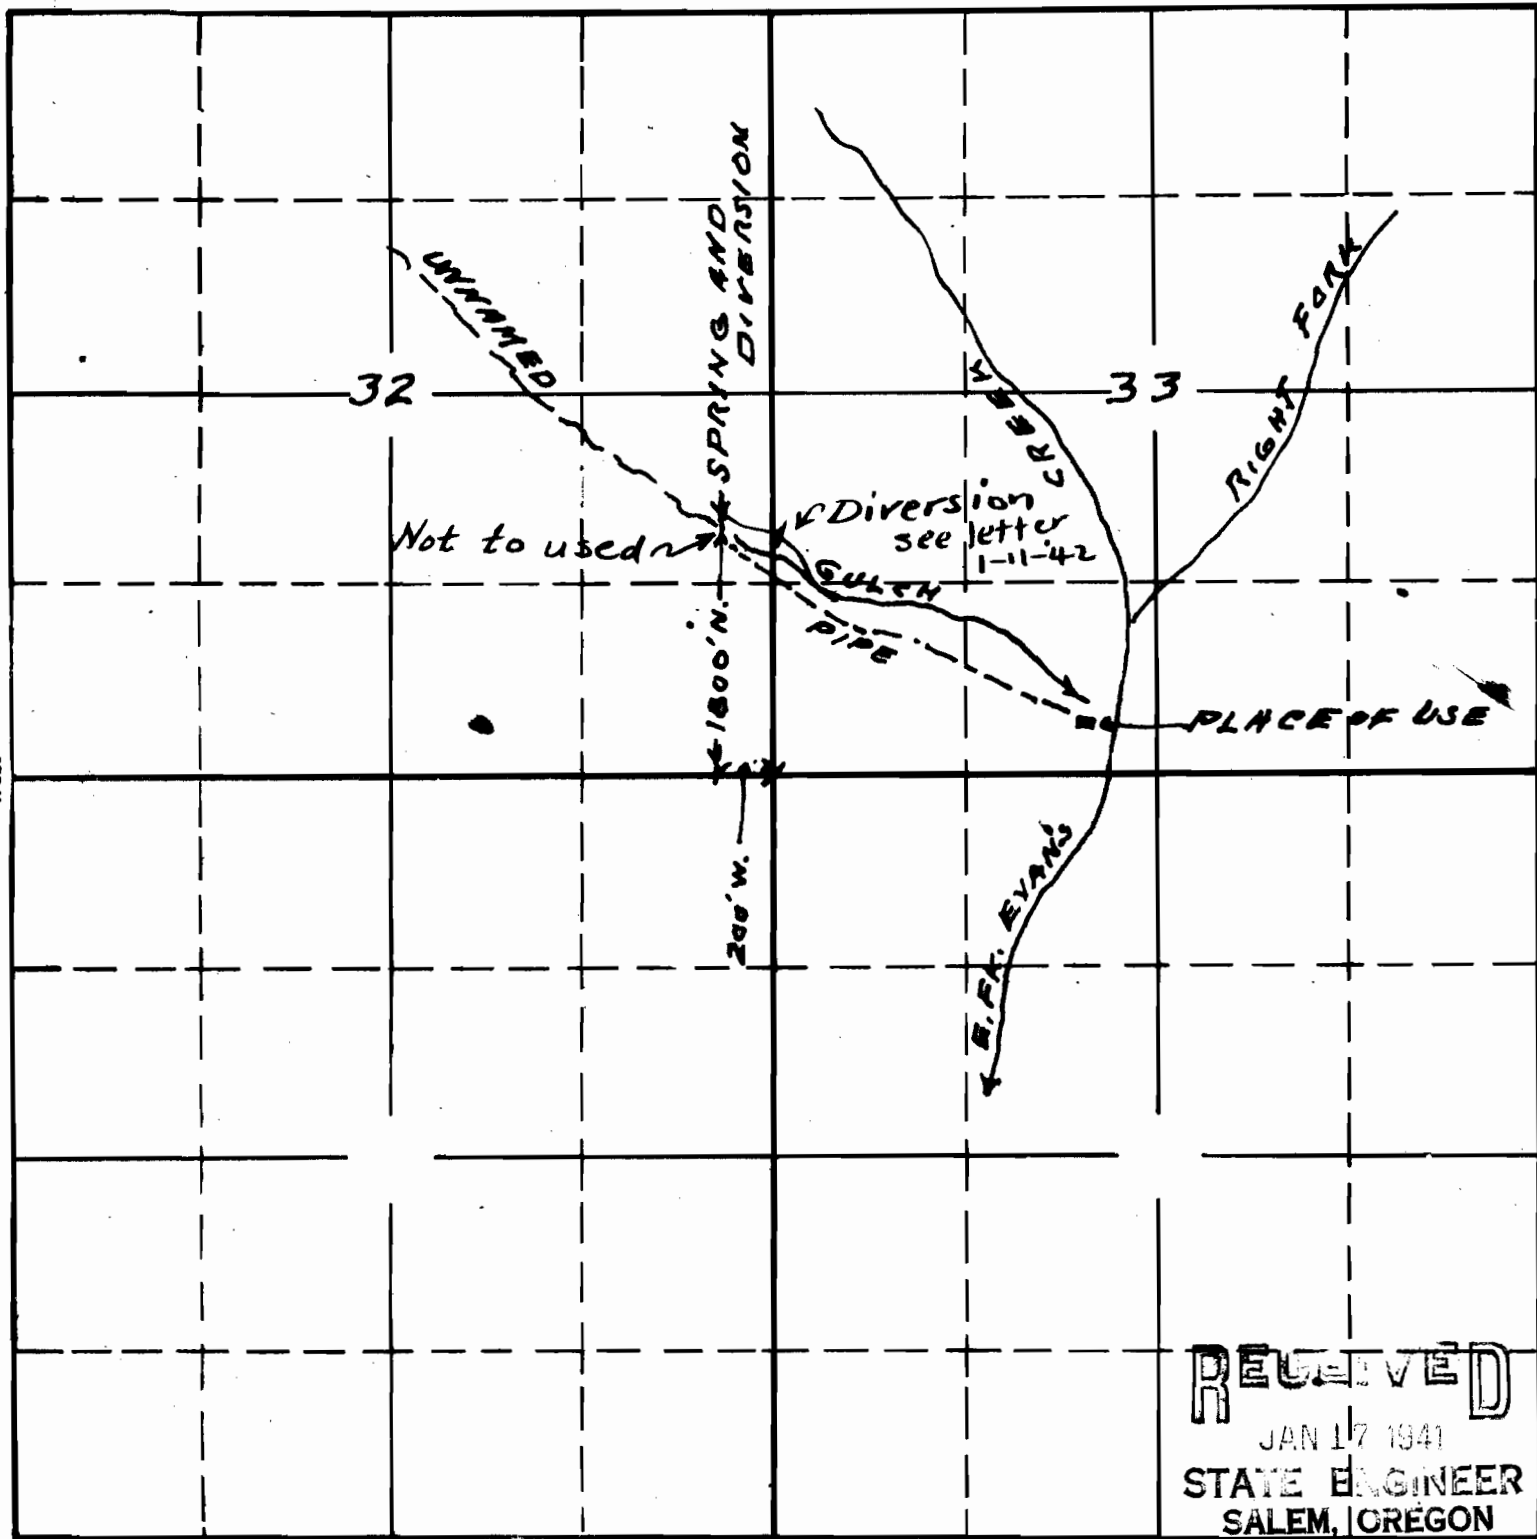

South

**RECEIVED**  
 JAN 17 1941  
 STATE ENGINEER  
 SALEM, OREGON

Sketch To accompany application of  
 E.D. Hall for use of The waters of  
 Spring and Unnamed gulch for  
 domestic and 1/2 ac. of garden

19135 OR  
 15-41  
 APPLICATION No. 19135  
 PERMIT No. 15167

*D.S.*  
 This office Jan 15 1941