


T.6S. R.IW.W.M.

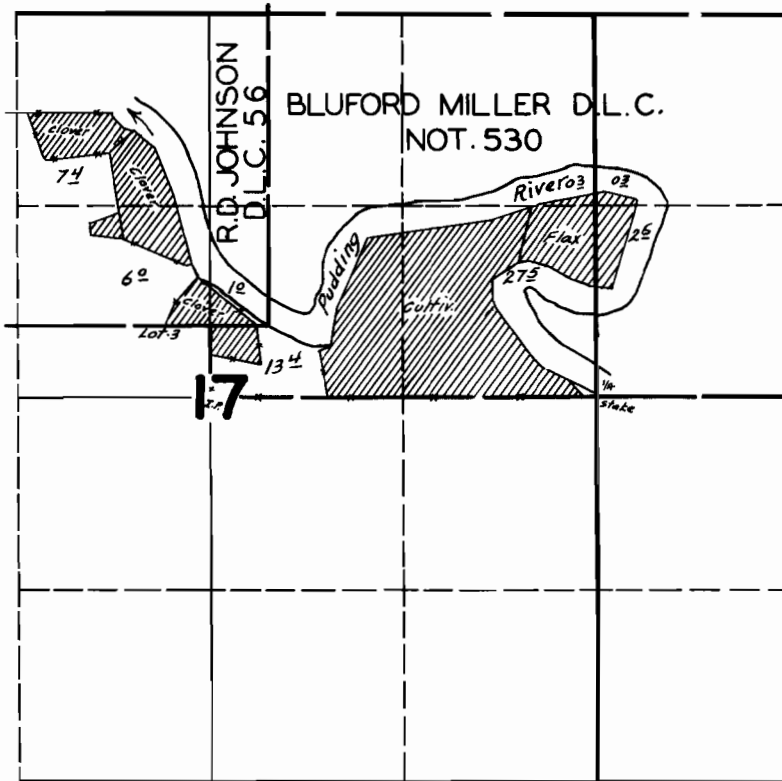

FINAL PROOF SURVEY UNDER

Application No. 19597 Permit No. 15184

IN NAME OF

LEONARD SEIFER

Surveyed MAY 23 1945, by