


T.7S. R.3W. W.M.

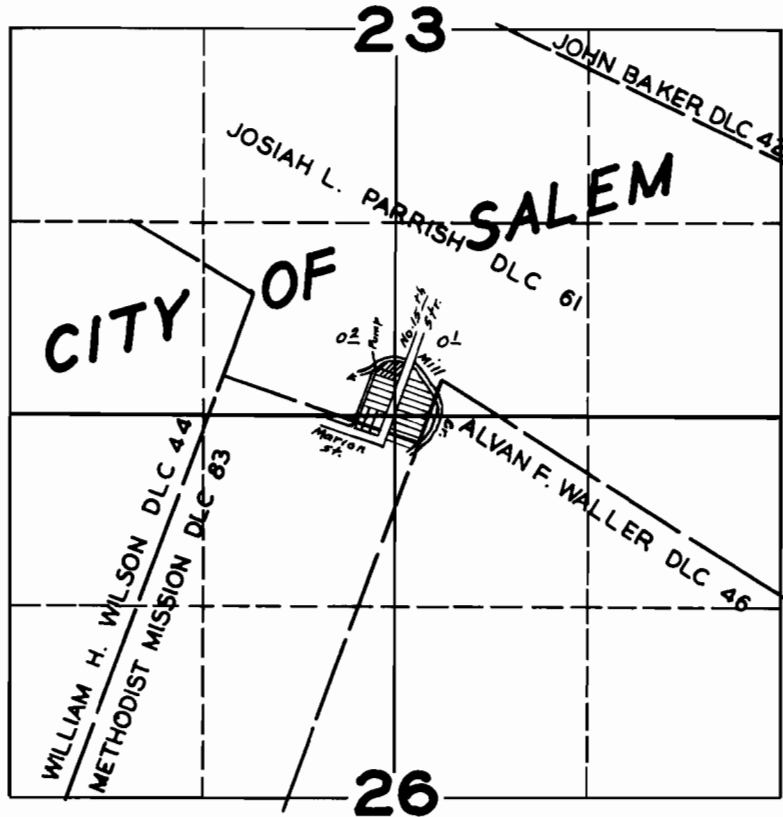

FINAL PROOF SURVEY

UNDER

Application No. 19728 Permit No. 15299

IN NAME OF

FLOYD K. BOWERS

Surveyed SEPT. 9 1944, by *James C. Bunnell*