


T.7S. R.4W.W.M.

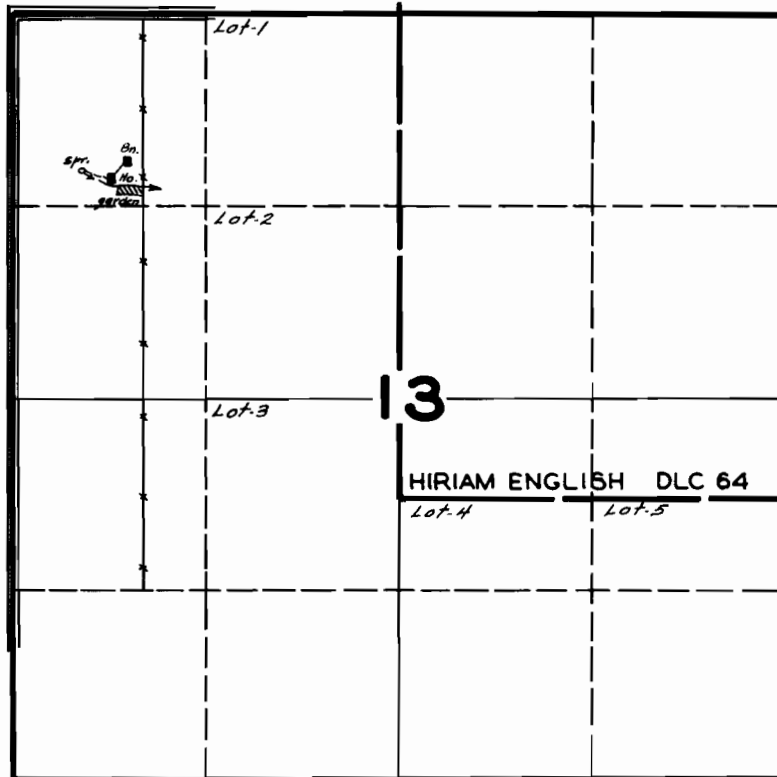

FINAL PROOF SURVEY UNDER

Application No. 19929 Permit No. 15503

W.G. & MARY FLORINE MCDOWELL

Surveyed DEC. 9, 1944, by *[Signature]*