

Permit: S 15606
Volume: 6
Strm: APPLEGATE R
Trib: ROGUE R
Priority: 9/17/43


0-1577

T.36 S. R.6 W. W.M.

RECEIVED

NOV 24 1976

WM. DIST. 14
GRANTS PASS. ORE.

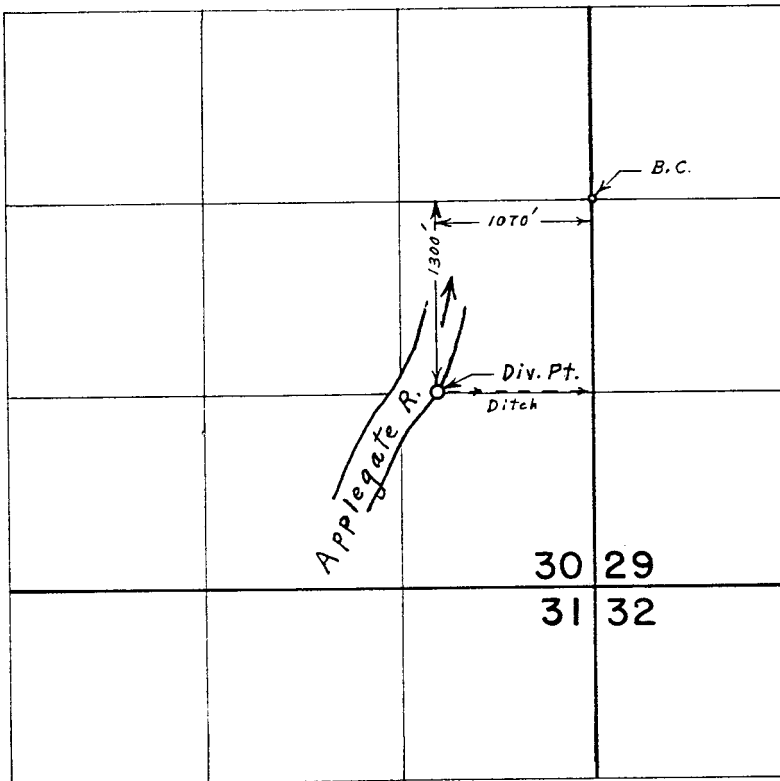

FINAL PROOF SURVEY
UNDER

Application No. _____ *Transfer No. 2792*
Permit No. _____

IN NAME OF

THOMAS R. HART JR.

Surveyed *May 20, 1974*, by *L. E. Gould*