

SECTION


16336

15339

17

TOWNSHIP 40S, RANGE 4E, W. M.

North

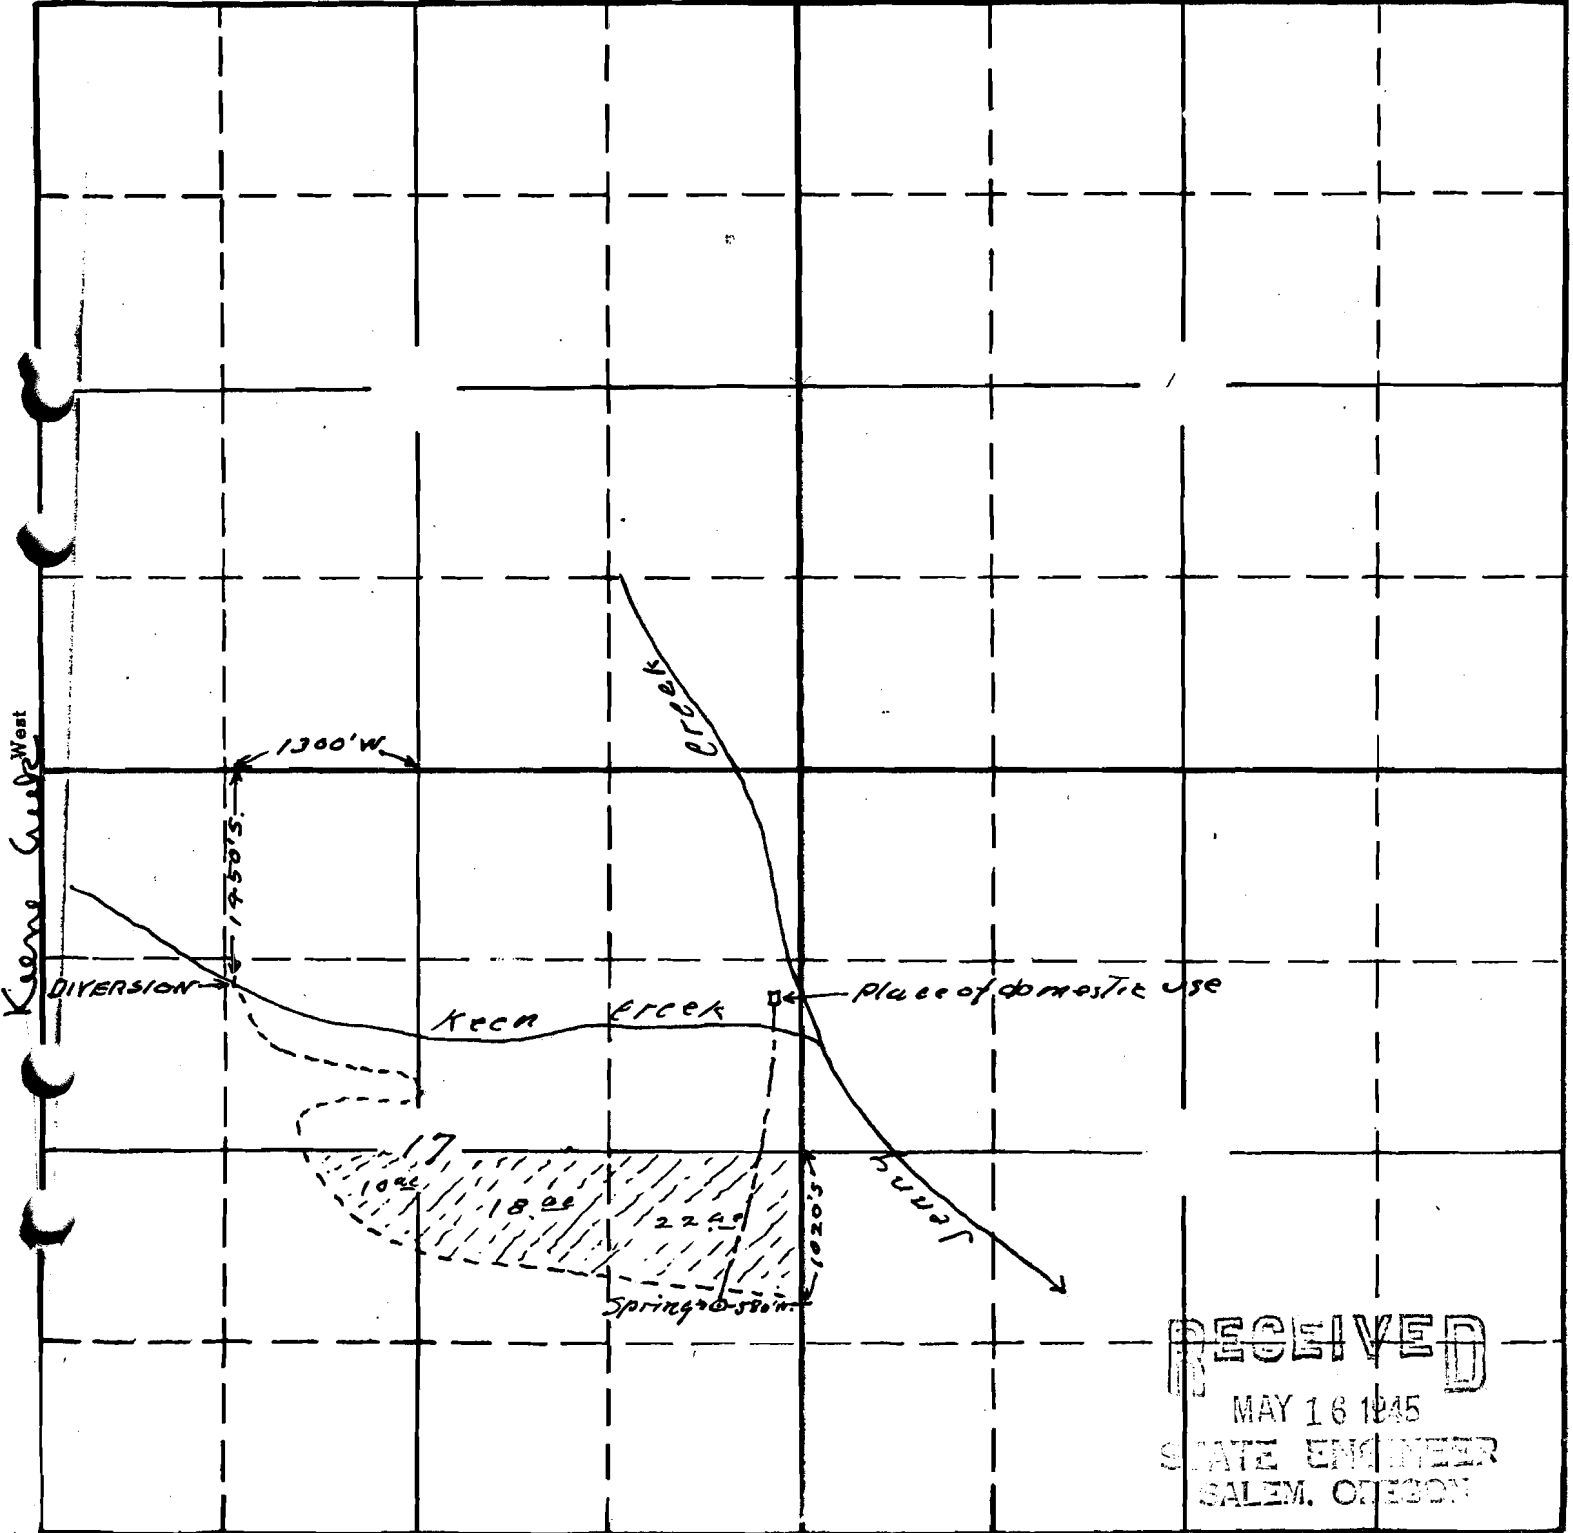

RECEIVED  
 MAY 16 1945  
 STATE ENGINEER  
 SALEM, OREGON

South

Map to accompany application of  
 Max and Elsie Desaredo for use of  
 waters of Senny Creek for irrigation  
 and domestic and stock purposes

20857  
 14-14  
 APPLICATION No. 20857  
 PERMIT No. 16336