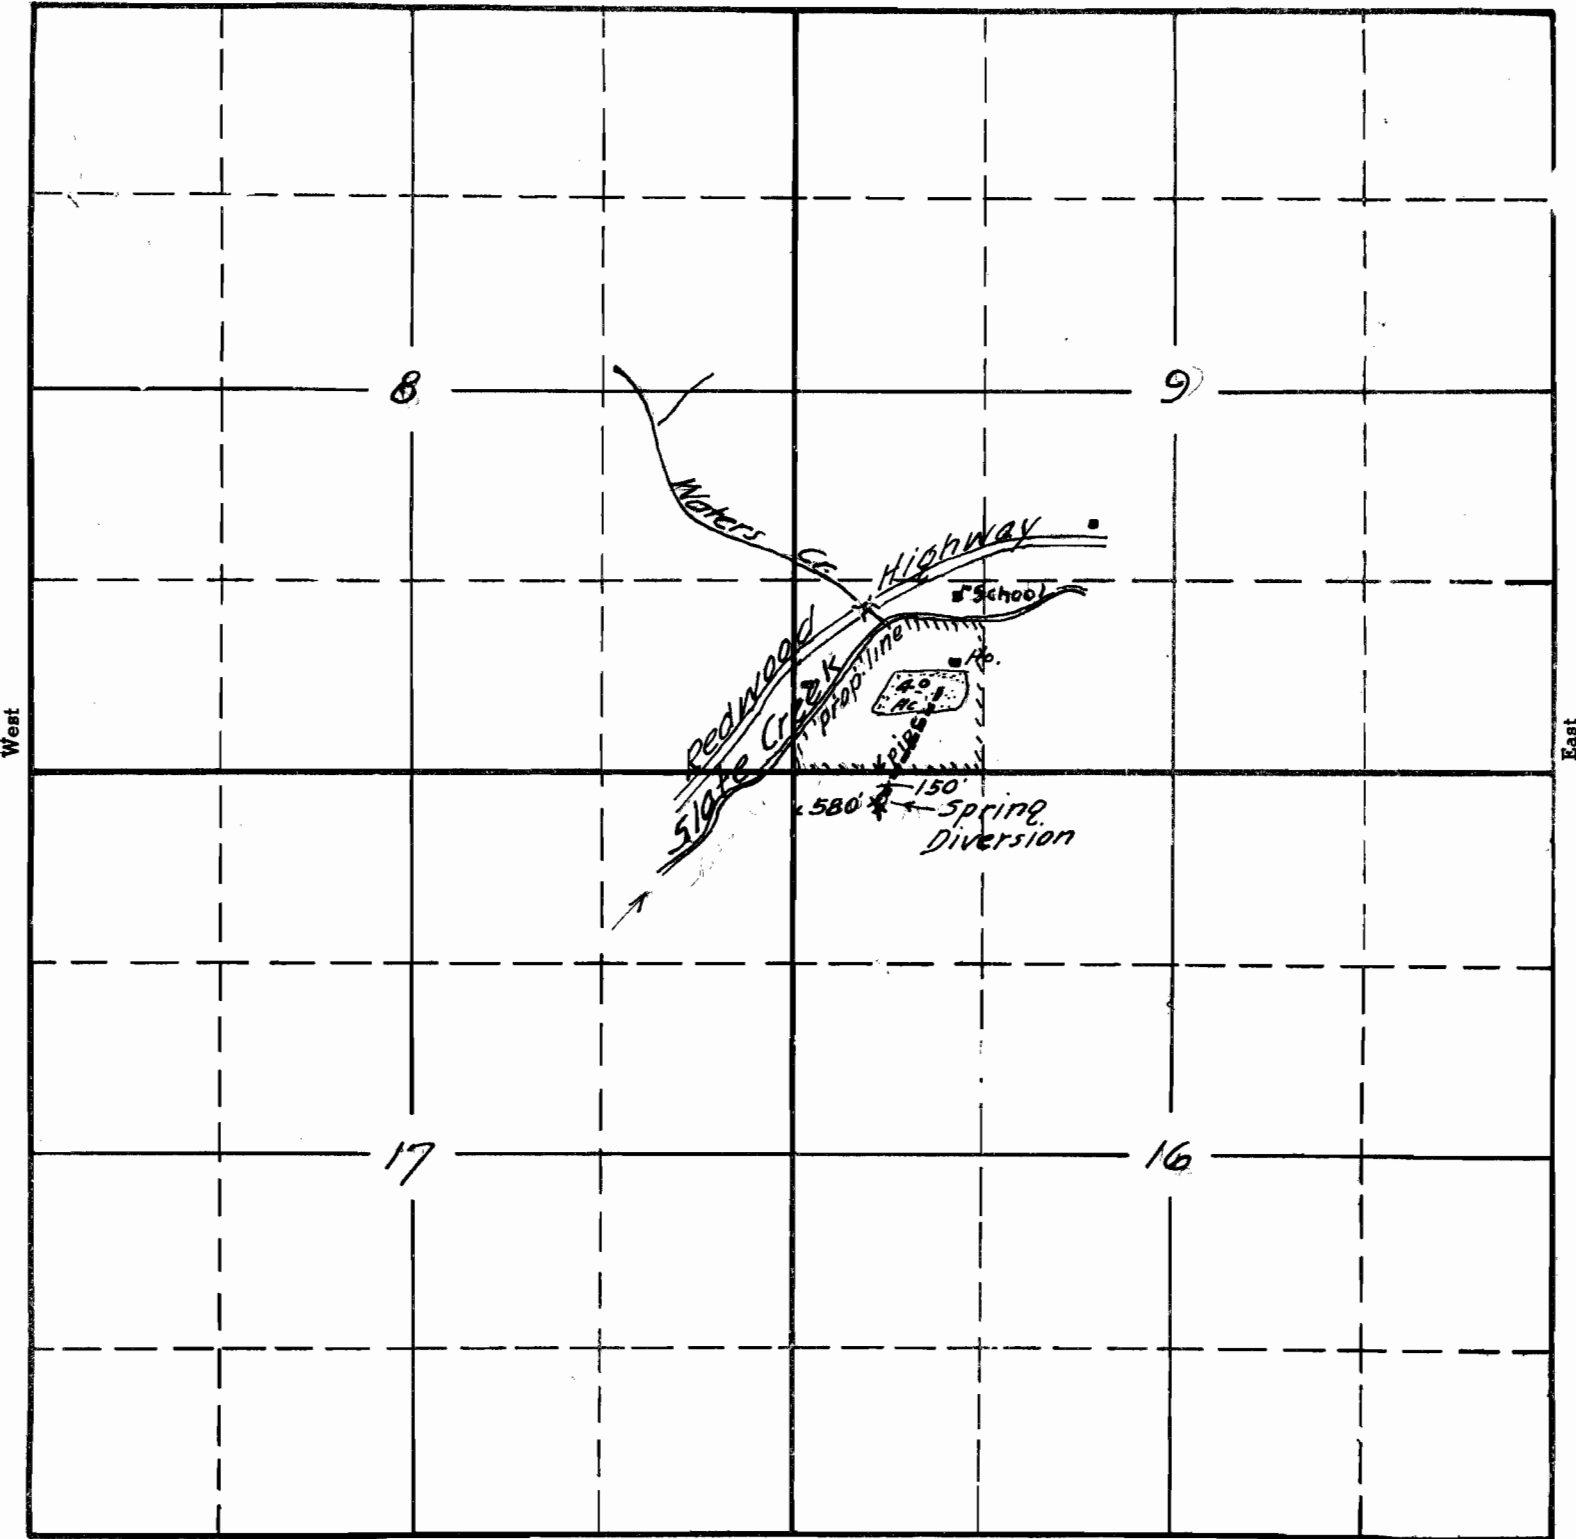

TOWNSHIP 37 S., RANGE 7 W., W. M.

North



South

RECEIVED

MAR 14 1945

STATE ENGINEER
DALEY, OREGON

Edith Fay
March 1945

APPLICATION No. 20735
PERMIT No. 16207

20735