


17

TOWNSHIP 40S, RANGE 4E, W. M.

North

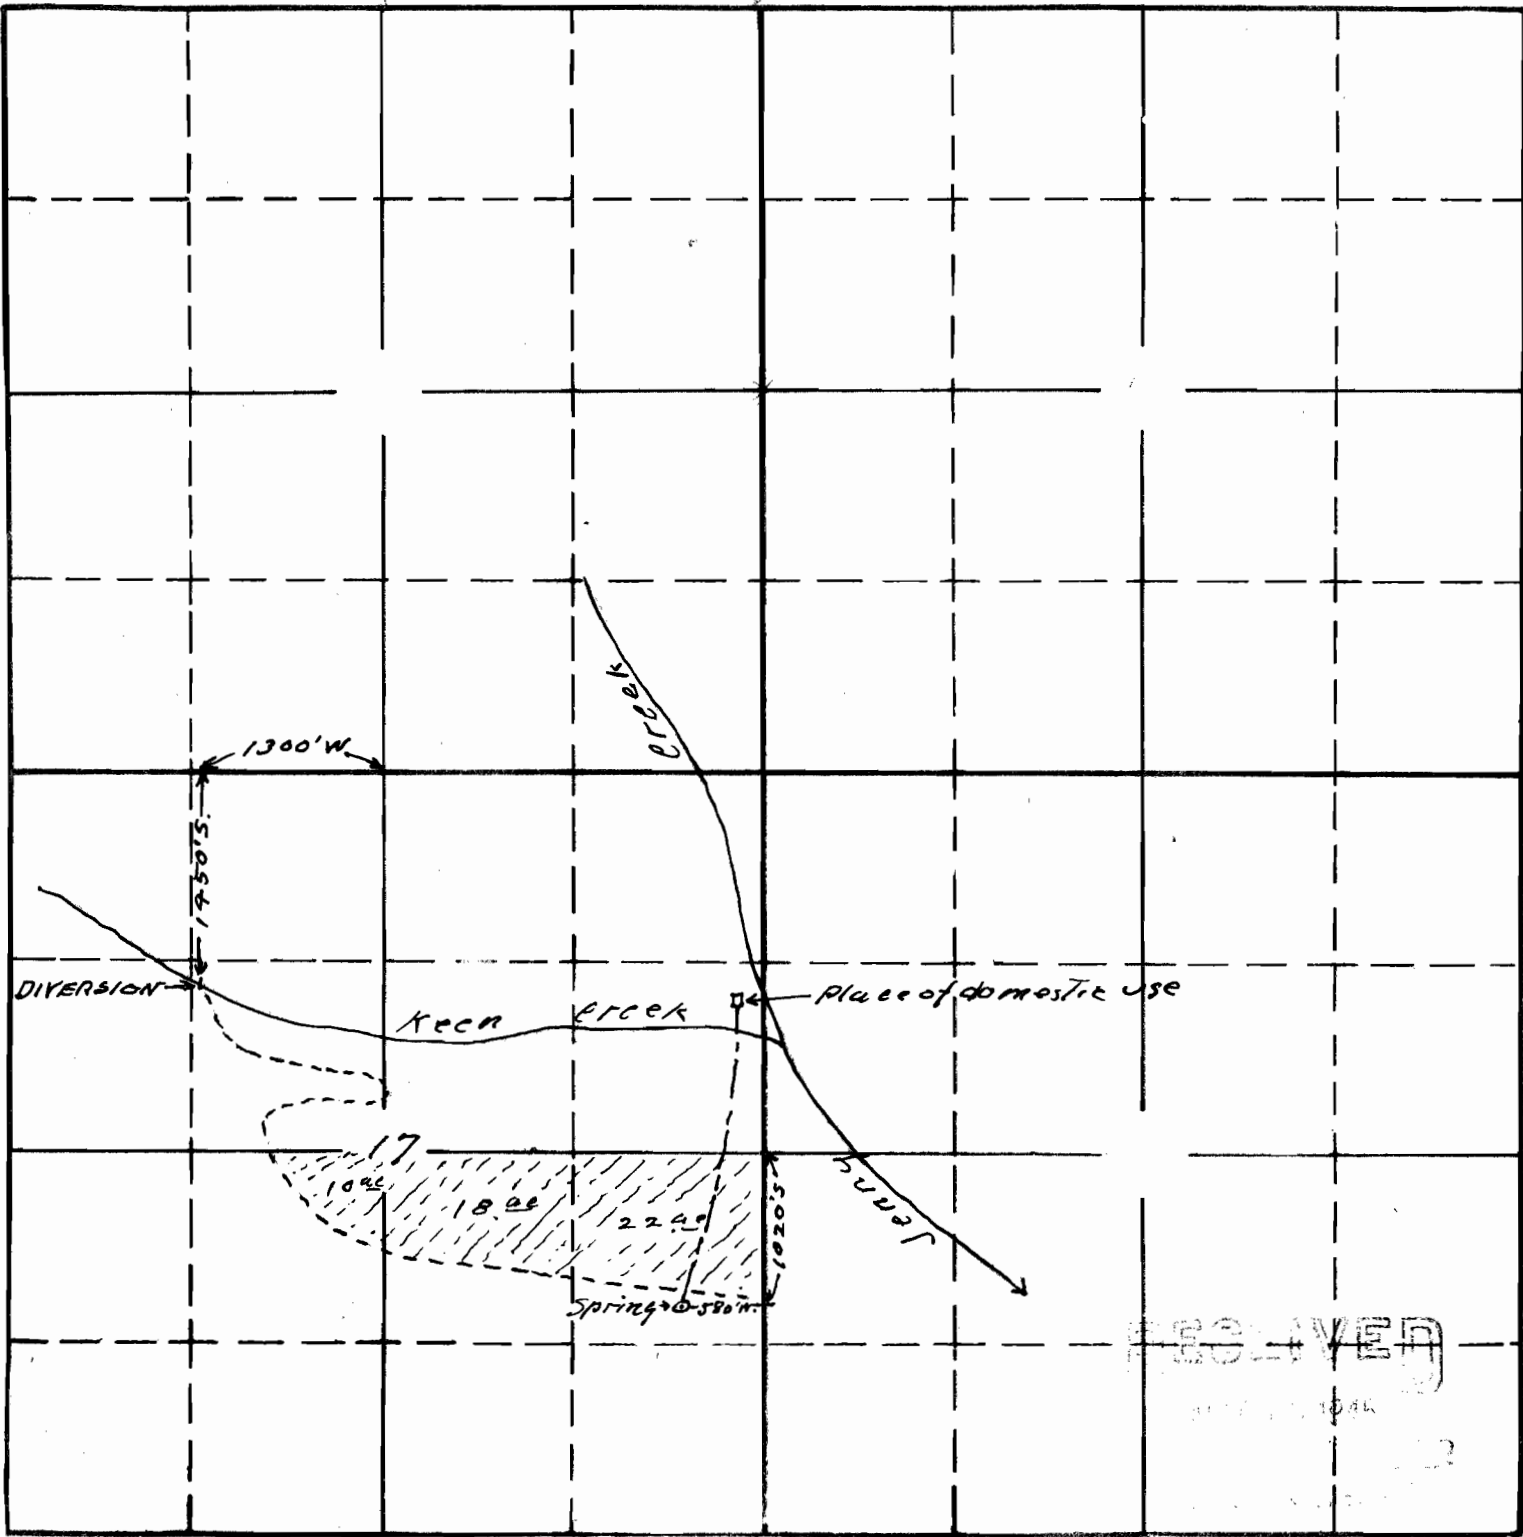

Map To accompany application of
Max and Elsie Desuredo for use of
waters of Senny Creek for irrigation
and domestic and stock purposes

RECEIVED
JUL 11 1944

20857
14-4
APPLICATION No. 20857
PERMIT No. 16336

This office 5/14/45 *[Signature]*