


SECTION

4

TOWNSHIP 37 S, RANGE 4 W, W. M.

North

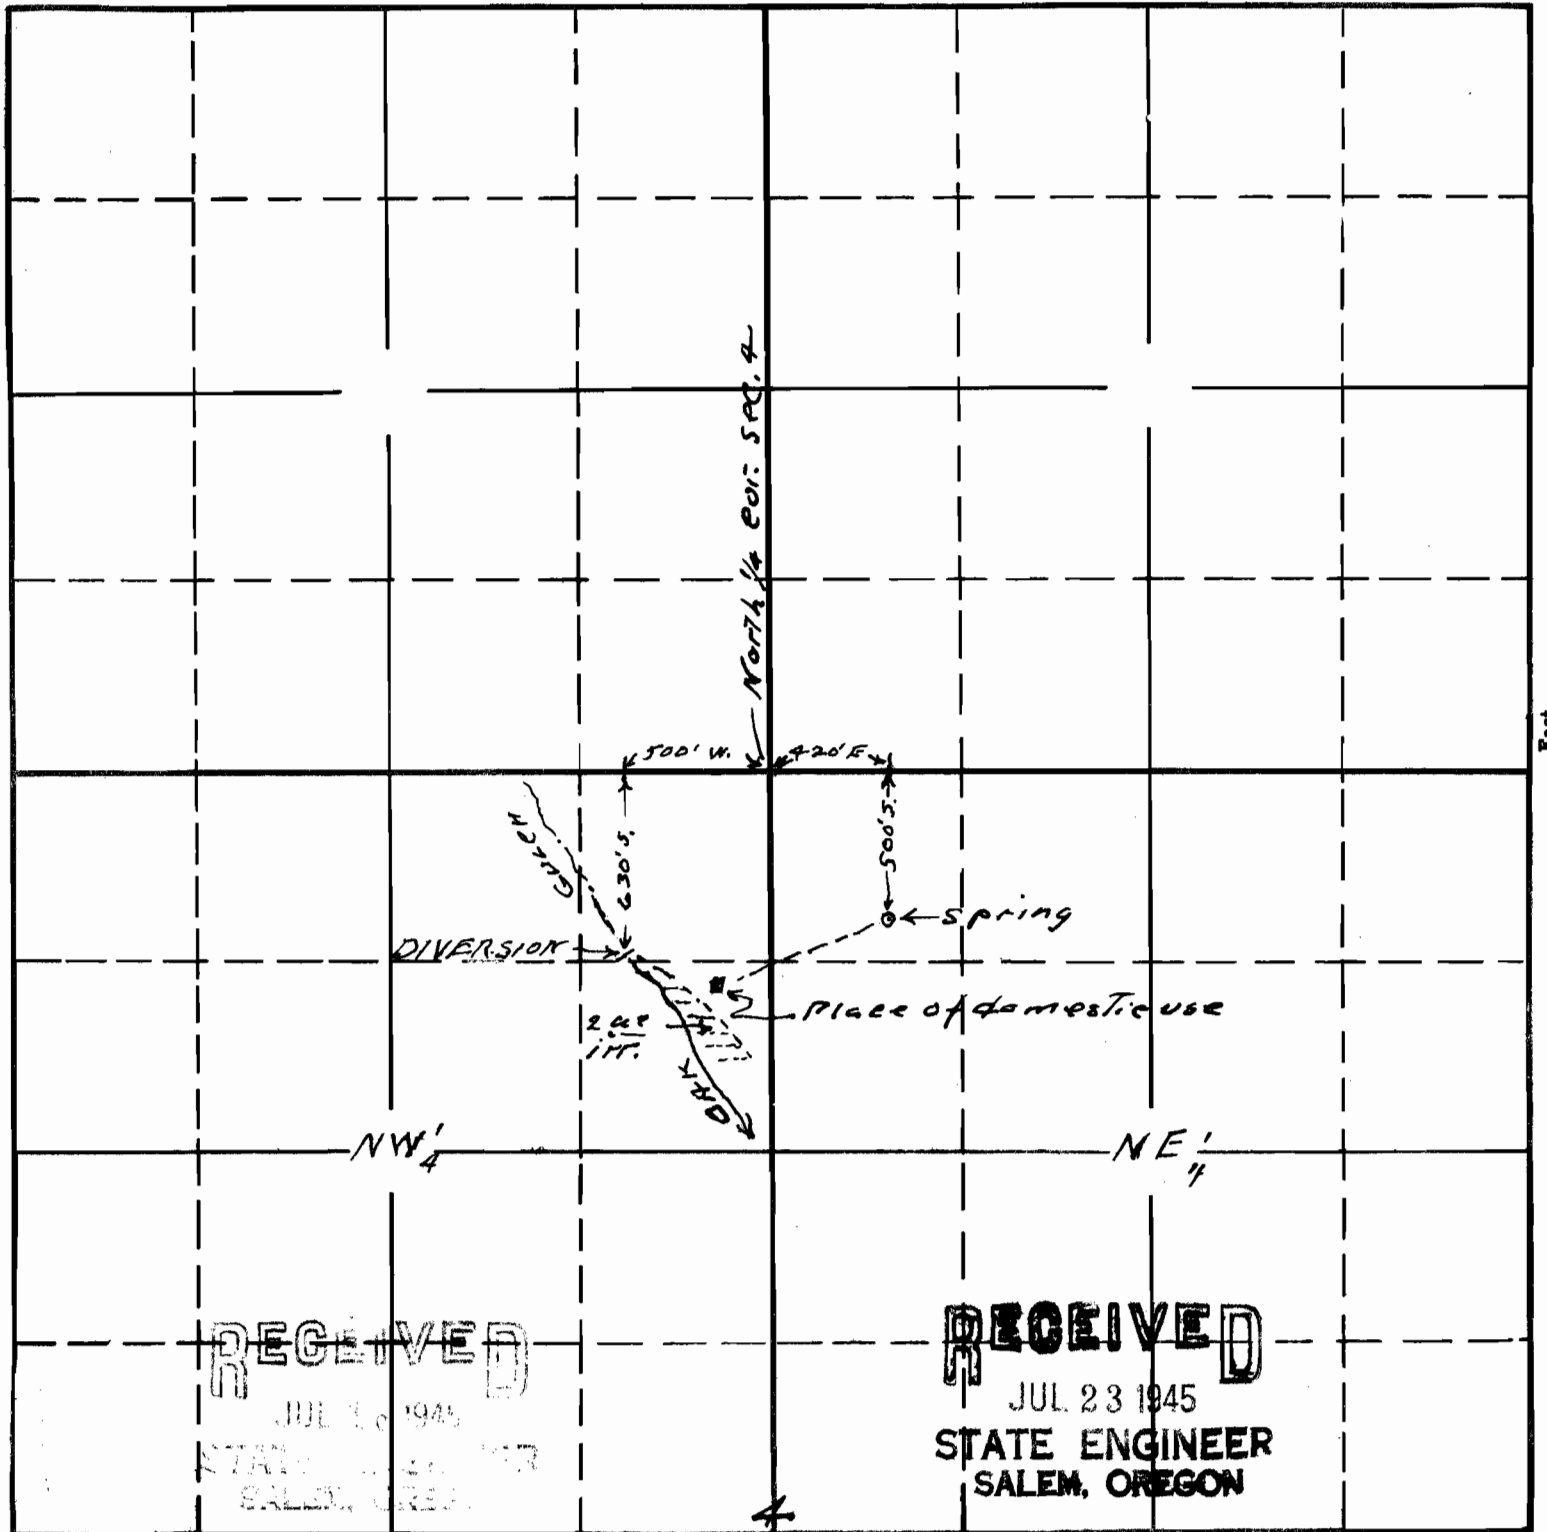

RECEIVED

JUL 16 1945

STATE ENGINEER  
SALEM, OREGON

RECEIVED

JUL 23 1945

STATE ENGINEER  
SALEM, OREGON

South

20969  
15-780

APPLICATION No. 20969

PERMIT No. 16415

Map To accompany application of  
W.M. Cotton for use of waters of  
Oak Gulch and unnamed spring  
for irrigation & domestic purposes

This office 7/12/45 *W.M. Cotton*