


SECTION

8

TOWNSHIP 37 S, RANGE 2 W, W. M.

North

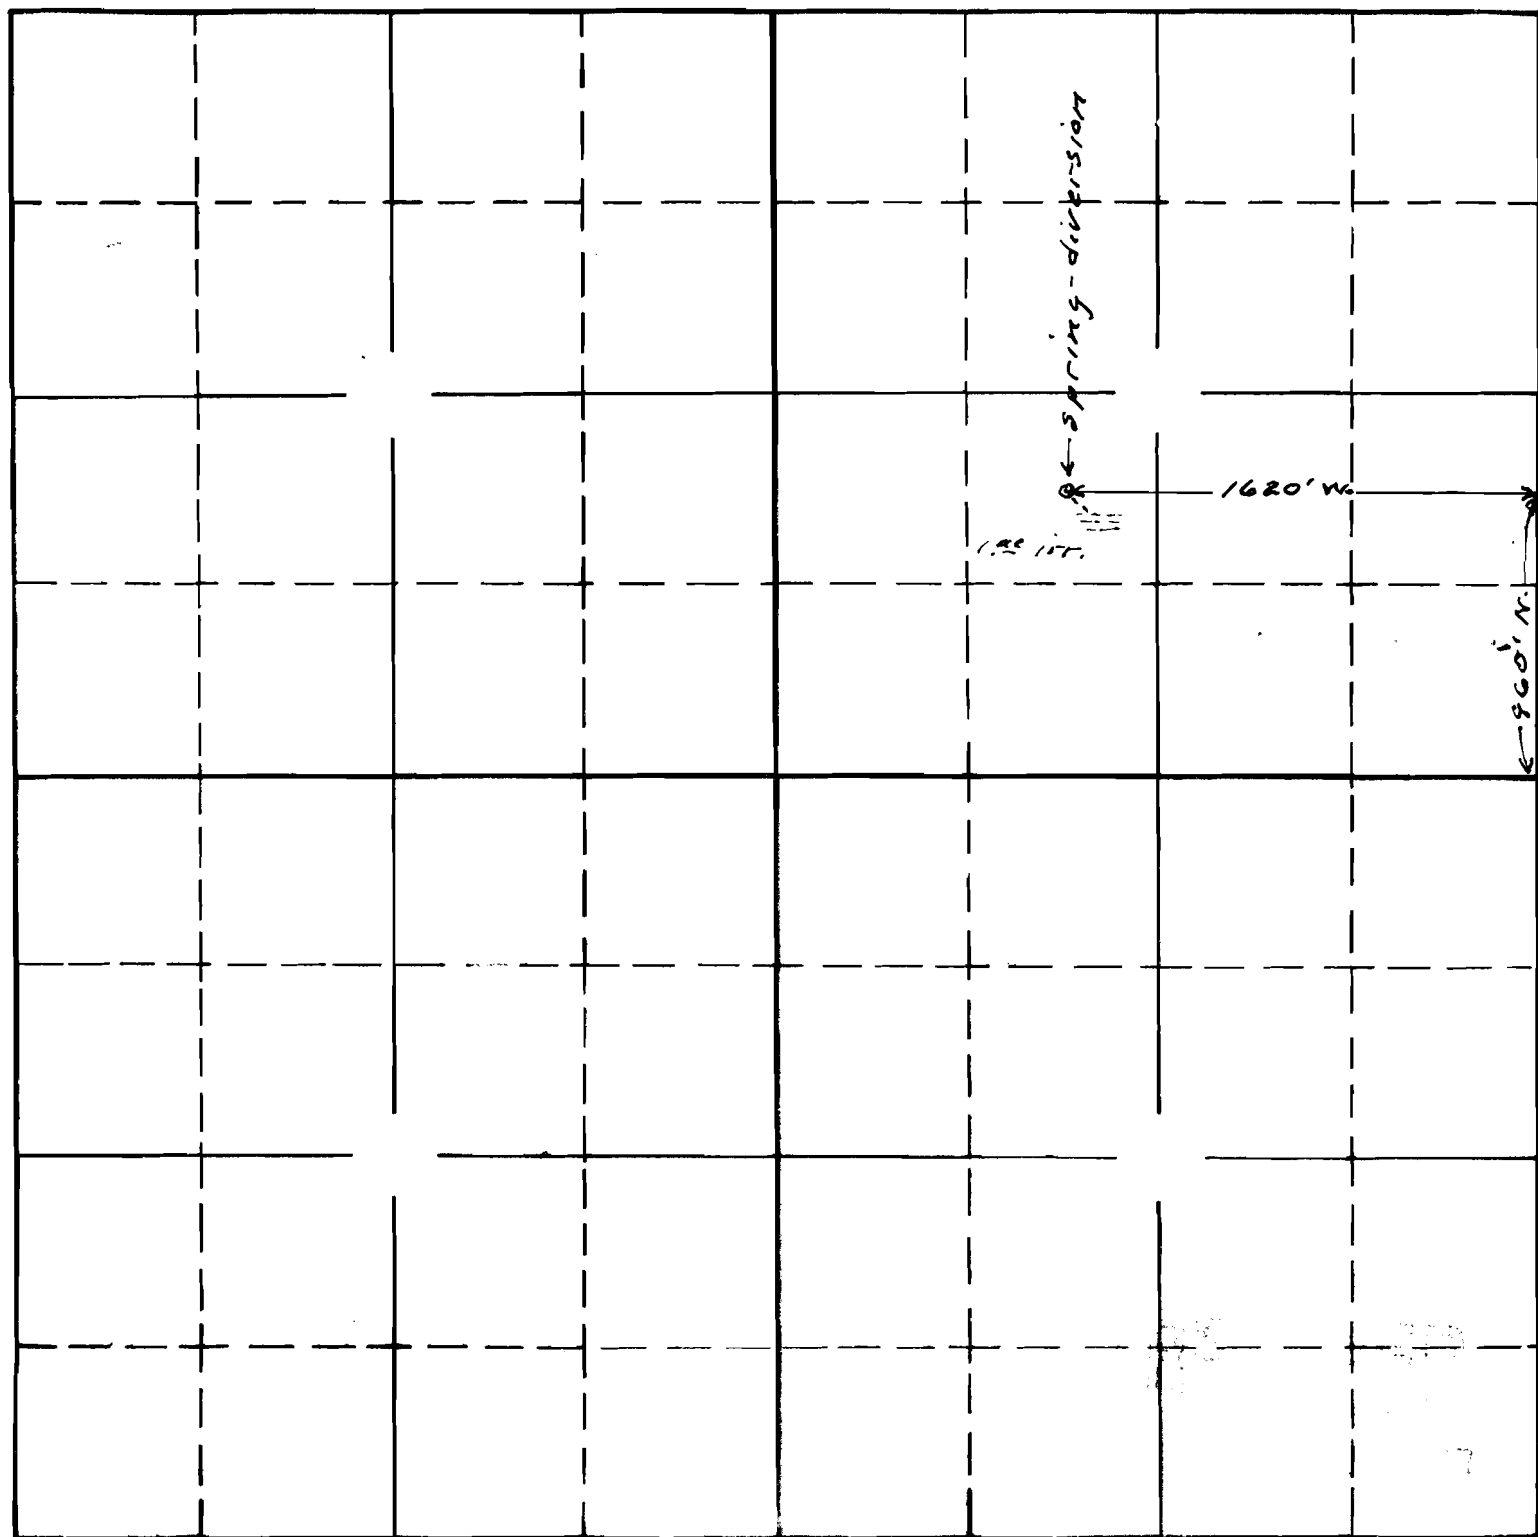

South

21381 15-24

Map to accompany application of
Ernest Untermann for use of waters
from spring on his lands for
irrigation of 1 acre

APPLICATION No. 21381

PERMIT No. 16748

This office 1/12/46 *[Signature]*