


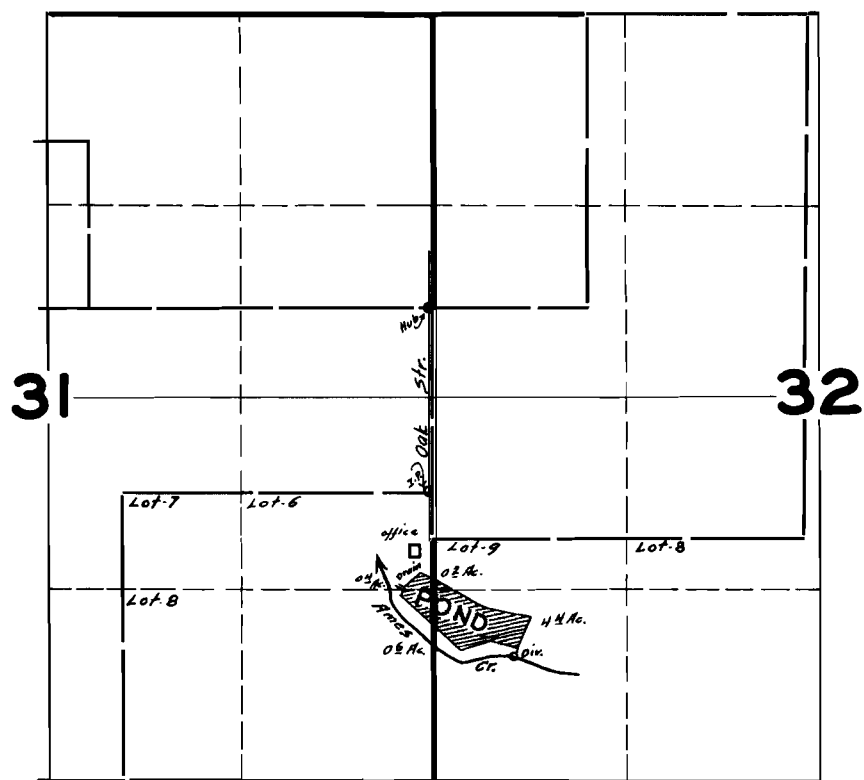

FINAL PROOF SURVEY

UNDER

Application No. R-19810 Permit No. R-776
19811 15423

IN NAME OF

~~LONG BELL LUMBER COMPANY~~

Surveyed JUNE 27 1945, by James E. Smith