


Sec.

Tp. 34 S.  
R 6 W.  
W.M.

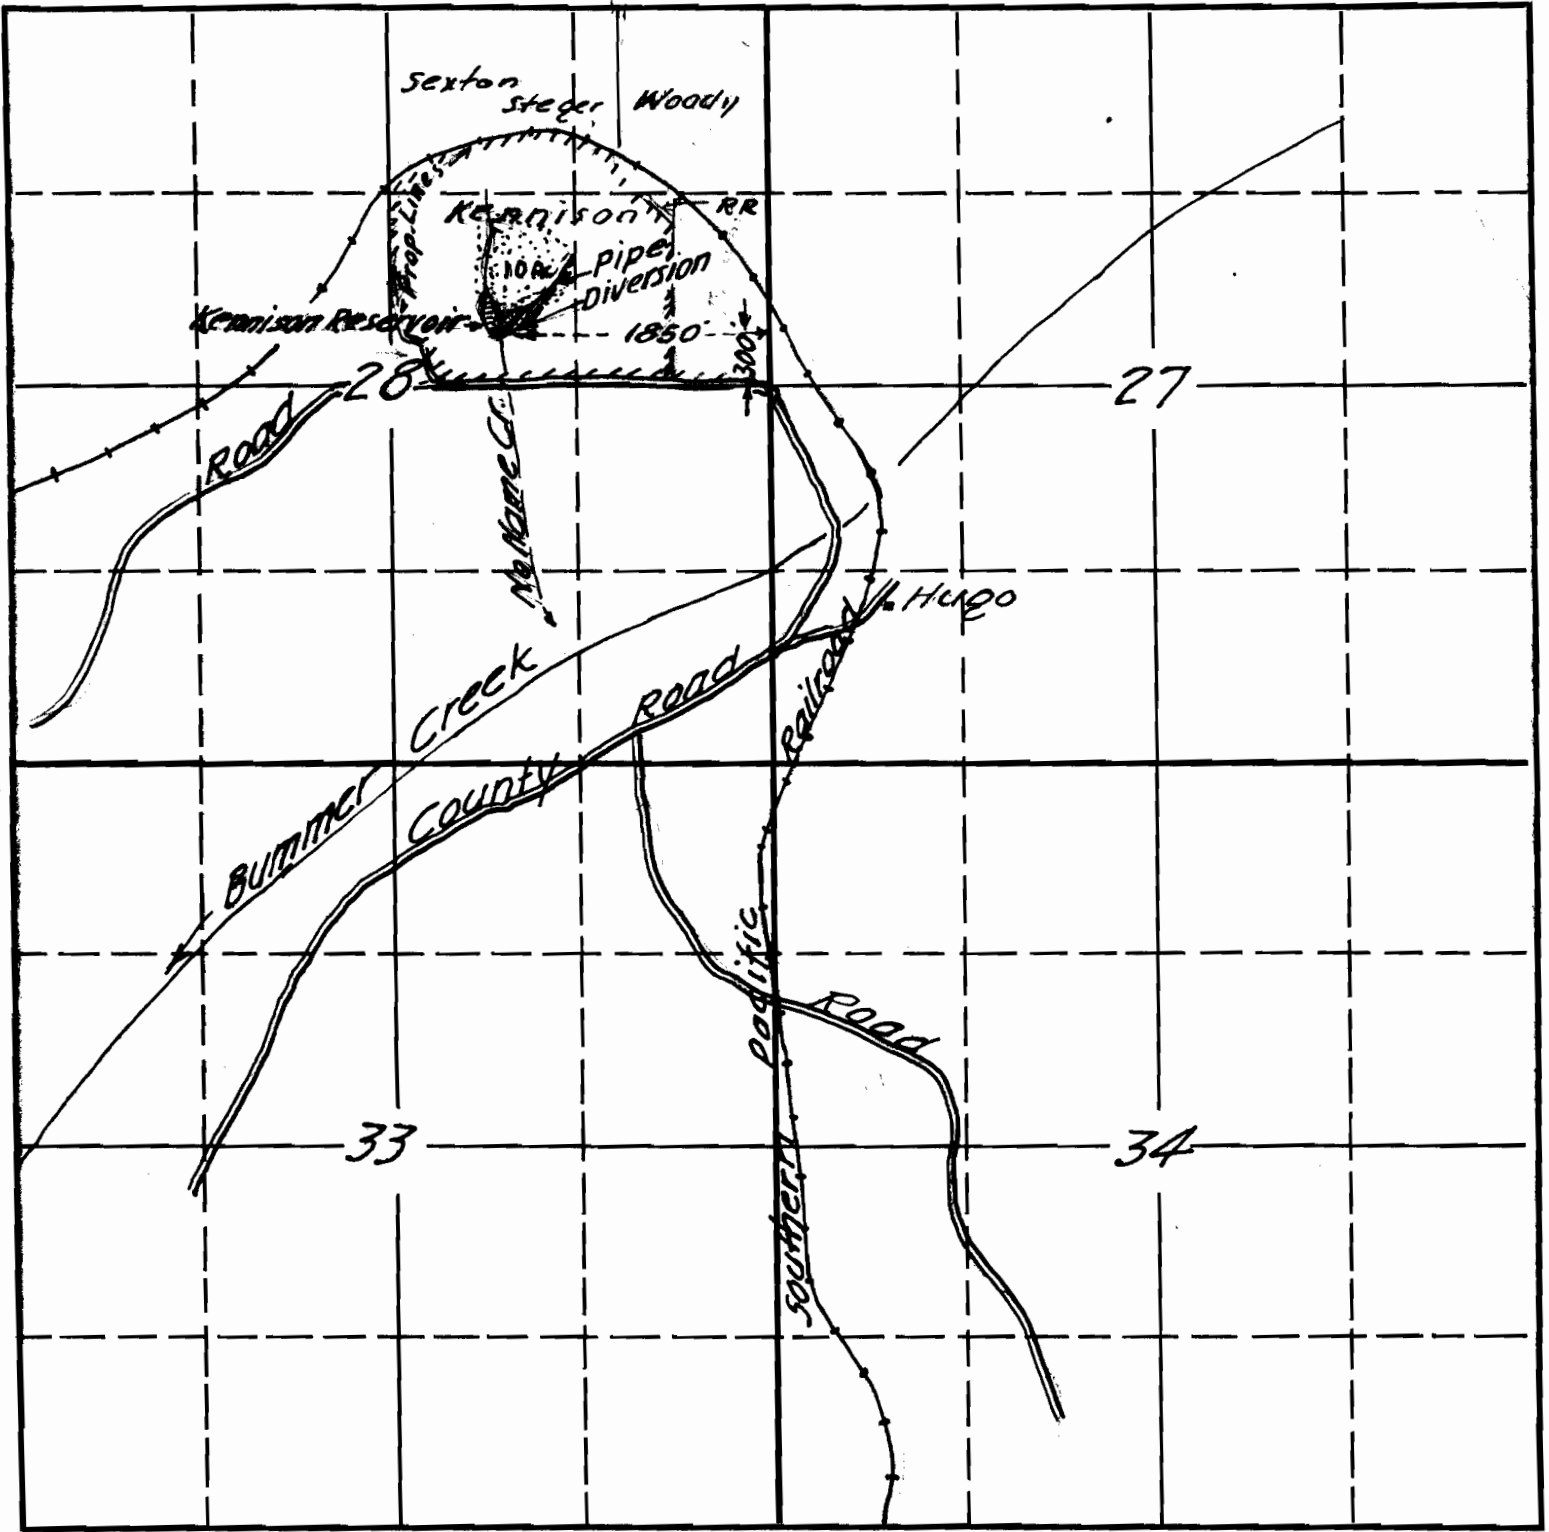

R.S. Kernison  
Sept. 1945

21150 15-78C  
 Application No. R-21149 - file  
 Permit No. R-826  
 16575

**RECEIVED**  
 STATE ENGINEER  
 SALEM, OREGON