


T. I. S. R. IOW. W. M.

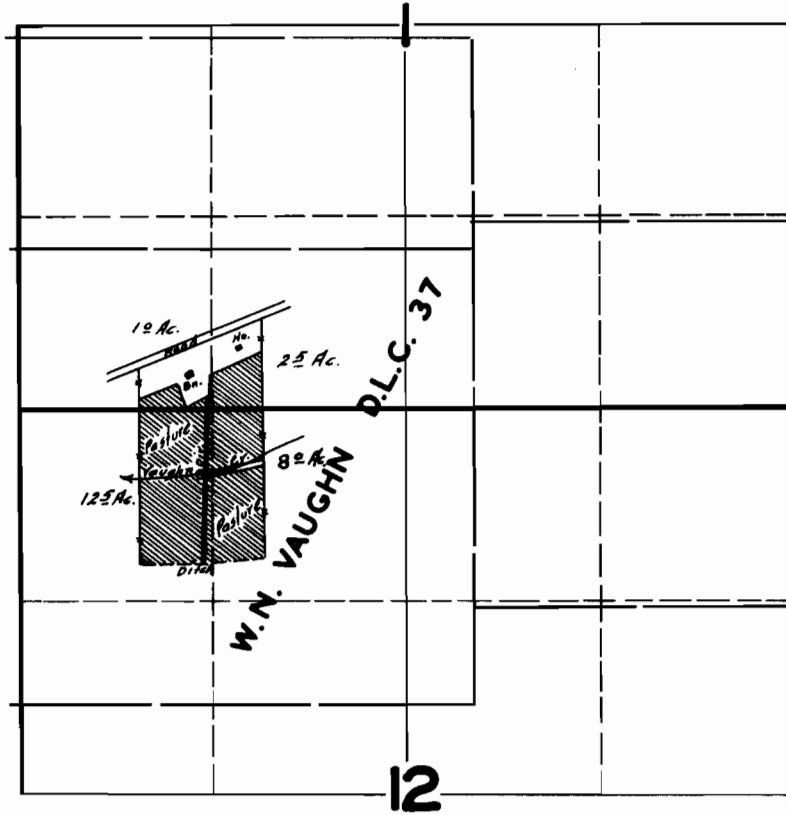

FINAL PROOF SURVEY UNDER

Application No. 15590 Permit No. 11740

IN NAME OF

JOHN KOMINOTH

Surveyed JUNE 19 1945 by [Signature]