


# T.12S. R.1W.W.M.

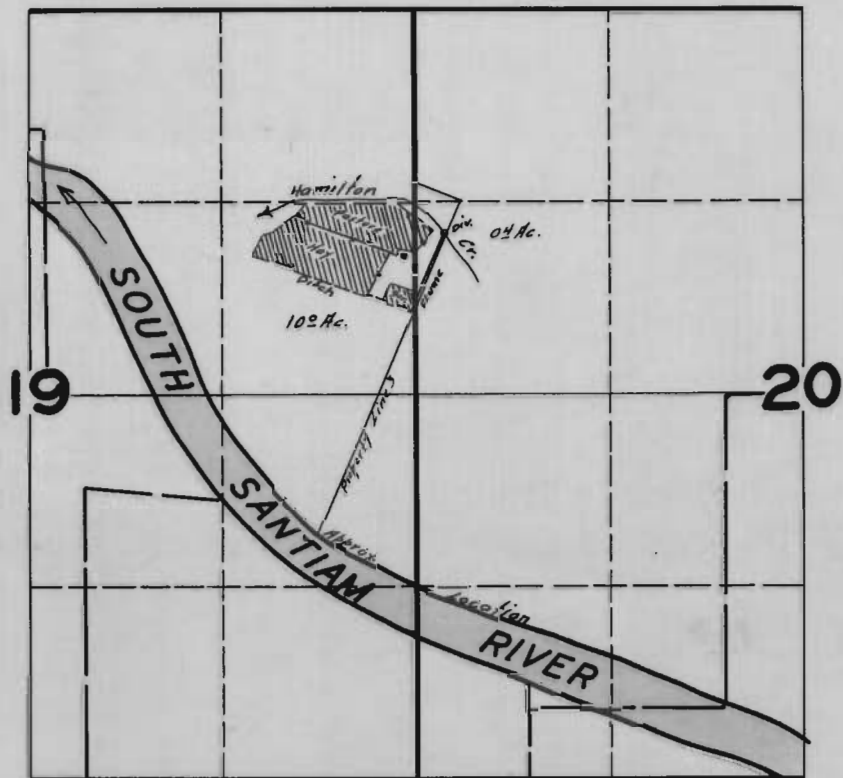

## FINAL PROOF SURVEY UNDER

Application No. 15663 Permit No. 11552

IN NAME OF  
J.G. REED.

Surveyed JUNE 30 1945, by [Signature]