


# T.5S.R.3W.W.M.

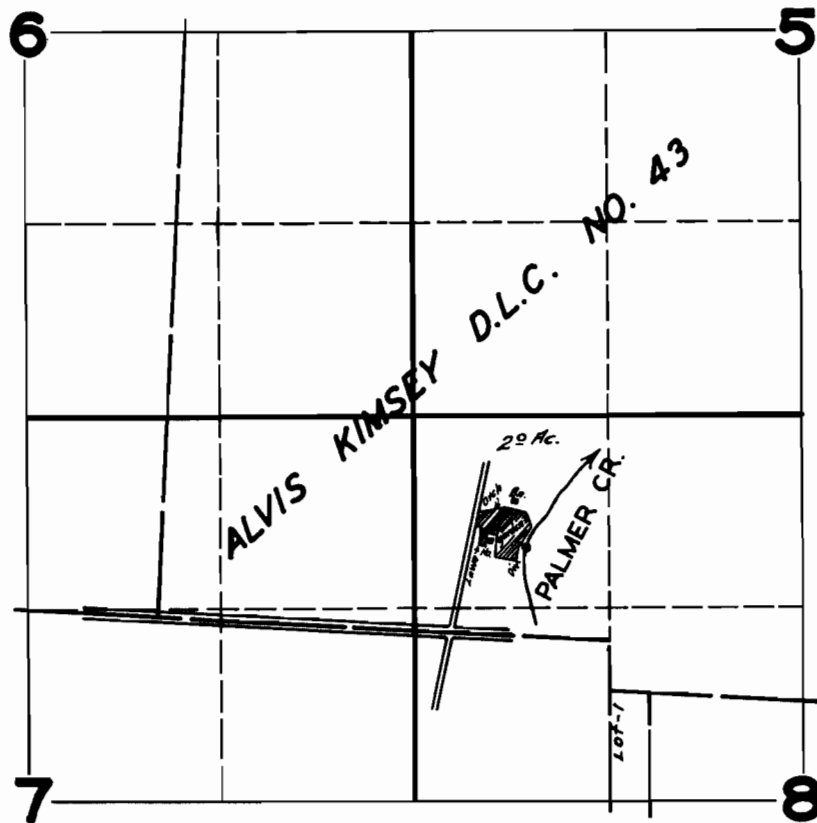

## FINAL PROOF SURVEY

UNDER

Application No. 15911 Permit No. 11748

IN NAME OF

W. L. JACKSON

Surveyed MAR. 20 1946, by [Signature]